PLAT OF SURVEY

PATHFINDER SURVEYING FORMERLY KOLB LAND CONSULTING 929 WILLIAMS STREET LAKE GENEVA, WI. 53147 (414) 248-3697

ORDERED BY: CENTURY 21 ZENK REALTY LLC

804 N. WISCONSIN ELKHORN, WI. 53121


DATE: 3-24-1999

DESCRIPTION:

LOTS 25, 26, 27, AND 28, BLOCK 2 ELKHORN GARDENS, AND THE WEST 25 FEET OF VACATED LOGAN AVENUE, ADJACENT TO LOT 25, CITY OF

LOGAN AVENUE, ADJACENT TO LOT 25, CITY OF ELKHORN, WALWORTH COUNTY, WISCONSIN.

SCALE 1"=20' BEARINGS REFERENCED TO

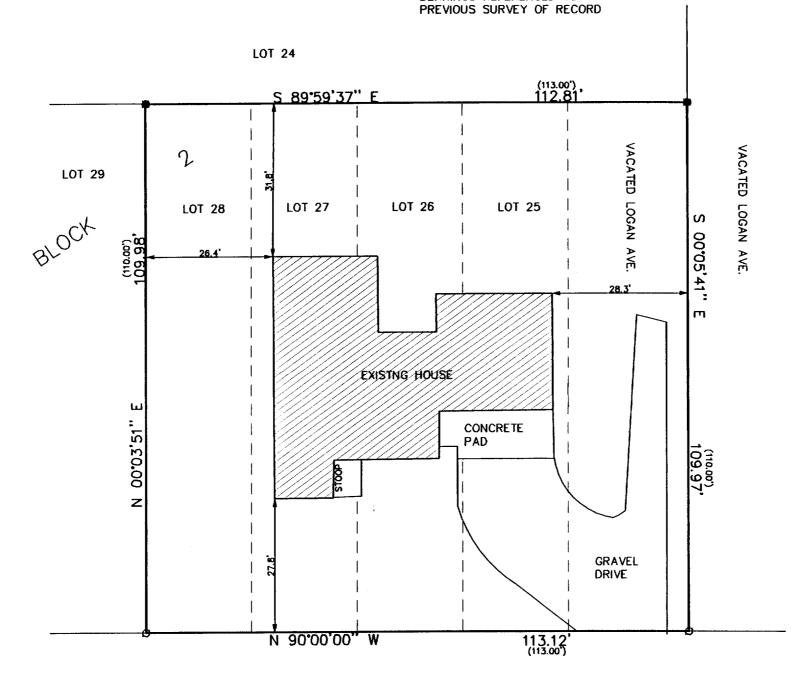

C.L. ROCKWELL STREET (66') WIDE

THE ABOVE MAP IS A TRUE REPRESENTATION THEREOF AND SHOWS THE SIZE AND LOCATION OF ALL THE PROPERTY, EXTERIOR BOUNDARIES, THE LOCATION OF ALL VISIBLE BOUNDARY FENCES, APPARENT EASEMENTS, ROADWAYS AND VISIBLE ENCROACHMENTS, IF ANY


THIS SURVEY IS MADE FOR THE USE OF THE PRESENT OWNERS OF THE PROPERTY, AND ALSO THOSE WHO PURCHASE, MORTGAGE OR GURANTEE TITLE THERETO WITHIN ONE (1) YEAR FROM DATE HERETO.


JOHN P. KROTT , R.L.S. 2258

LEGEND

- Ø FOUND IRON PIPE
- FOUND IRON PIN

(XXX) RECORDED AS

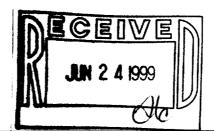

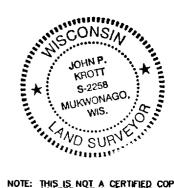

NOTE: THIS IS NOT A CERTIFIED COPY UNLESS SEAL IS IN RED.

JOB NUMBER 99051 ELK YEN00014A

OP4-1170

YEN-14A