PATHFINDER SURVEYING FORMERLY KOLB LAND CONSULTING 929 WILLIAMS STREET LAKE GENEVA, WI. 53147 (414) 248-3697

ORDERED BY:

CENTURY 21 SKANDIA REALTY INC.

822 EAST GENEVA DELAVAN, WI. 53115 DATE: 4-14-1999


66,

STR

DESCRIPTION:

LOT 4 BLOCK 9 OF THE ORIGINAL PLAT OF THE VILLAGE OF ELKHORN, NOW CITY OF ELKHORN, WALWORTH COUNTY, WISCONSIN.

> SCALE 1"=20' BEARINGS REFERENCED TO PREVIOUS SURVEY OF RECORD

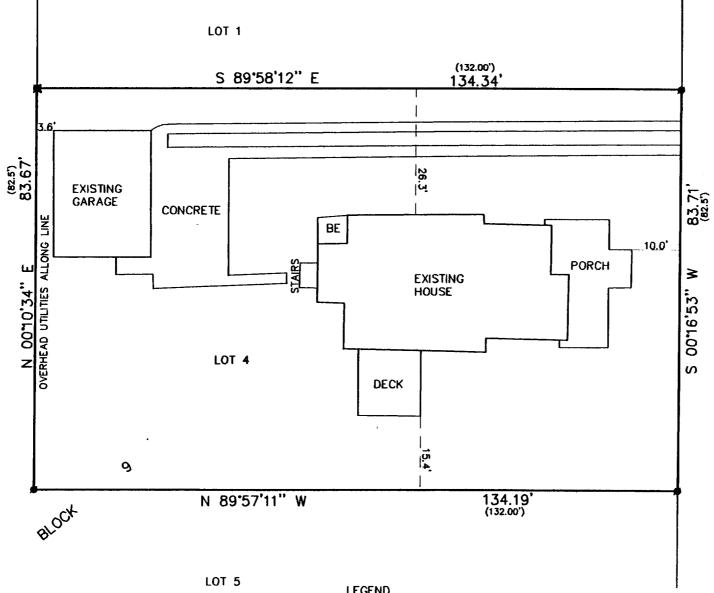

LEGEND

- FOUND IRON PIN
- SET IRON PIPE
- BASEMENT ENTRANCE

(XXX) RECORDED AS

THE ABOVE MAP IS A TRUE REPRESENTATION THEREOF AND SHOWS THE SIZE AND LOCATION OF ALL THE PROPERTY. EXTERIOR BOUNDARIES, THE LOCATION OF ALL VISIBLE BOUNDARY FENCES, APPARENT EASEMENTS, ROADWAYS AND VISIBLE ENCROACHMENTS, IF ANY

THIS SURVEY IS MADE FOR THE USE OF THE PRESENT OWNERS OF THE PROPERTY, AND ALSO THOSE WHO PURCHASE, MORTGAGE OR GURANTEE TITLE THERETO WITHIN ONE (1) YEAR FROM DATE HERETO.

JOHN P. KROTT, R.L.S. 2258





NOTE: THIS IS NOT A CERTIFIED COPY UNLESS SEAL IS IN RED. JOB NUMBER #990069 YOP 00042

YOP-42