


Wisconsin Registered Land Surveyor S-1594

Rt. 3, Box 273
Elkhorn, Wisconsin 53121
Phone: (414) 723-4260 (office)
(414) 723-4813 (residence)





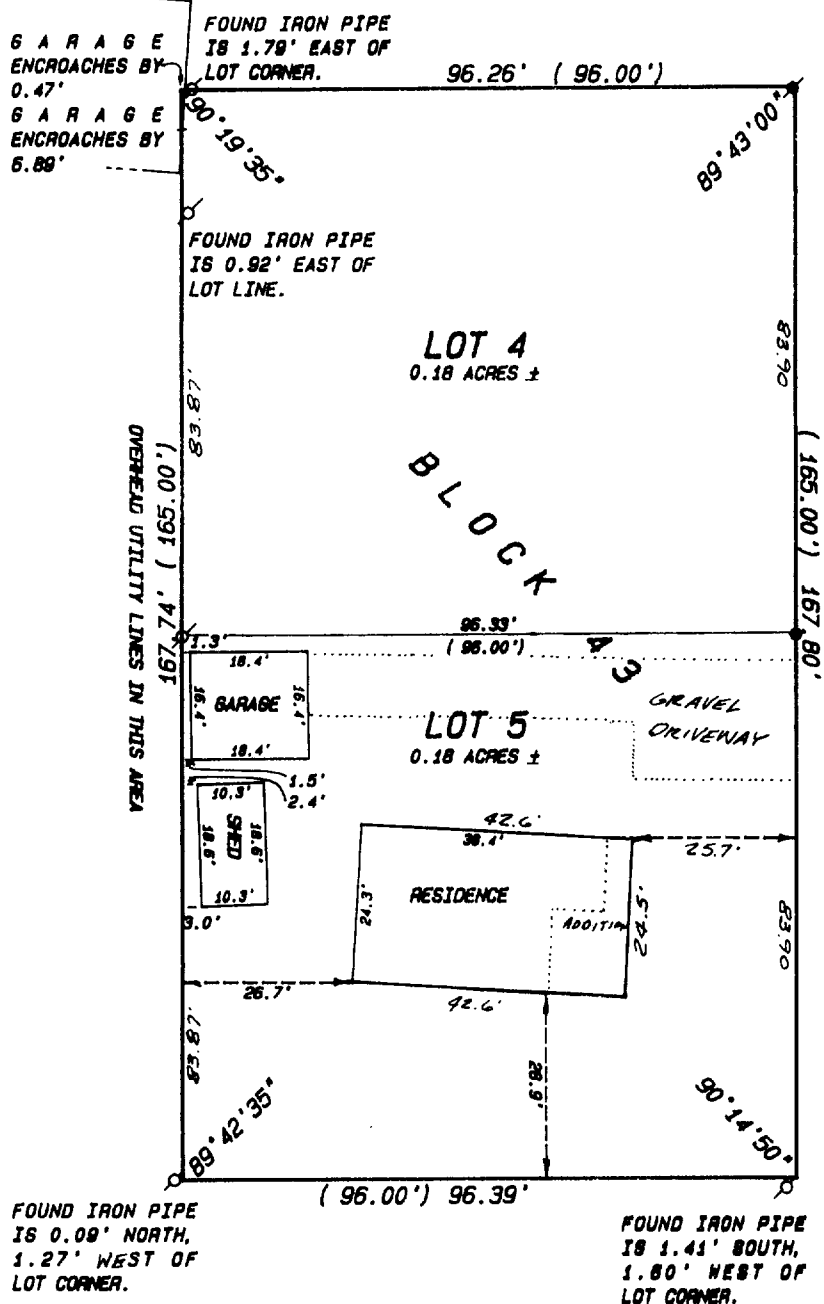


Lots 4 & 5 of Block 43 of Davis Addition, City of Elkhorn, County of Walworth, State of Wisconsin.


Ordered by : Atty. Alice Morrissy
Post Office Box 470
Elkhorn, Wisconsin 53121
Personal Representative of
the Herbst Estate
Buyer : Dorothy Achille



NOTE : BLOCK PRORATION IS BASED ON TUBB'S RECORDS AND EXISTING MONUMENTATION.

Legend

-  FOUND IRON PIPE
 FOUND IRON ROD
 FOUND BRASS CAPPED MONUMENT
 FOUND CONCRETE MONUMENT
 CHISEL CUT IN CONCRETE
 SET IRON ROD, 24" LONG, WEIGHING
1.5 LBS./LINEAL FT., 3/4" DIA.
 SET IRON ROD, 30" LONG, WEIGHING
4.5 LBS./LINEAL FT., 1-11/16" DIA.
(XX) RECORDED AS DIMENSION
—X—X— EXISTING FENCE

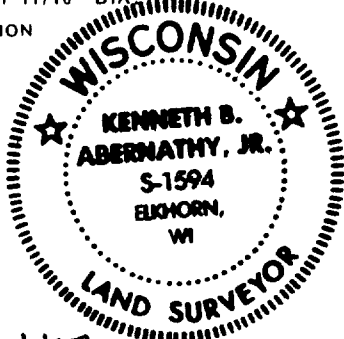

SCALE: 1" = 30 FEET

"I hereby certify that I have surveyed the above described property and that the above map is a true representation thereof and shows the size and location of the property, its exterior boundaries, the location of all visible structures and dimensions of all principal buildings thereon, boundary fences, apparent easements, roadways and visible encroachments, if any."

"This survey is made for the use of the present owners of the property, and also those who purchase, mortgage, or guarantee the title thereto within one year from date hereof."

Kenneth B. Albrecht, Jr.

KENNETH B. ABERNATHY, JR.
WISCONSIN REGISTERED LAND SURVEYOR,
REVISED 7/30/00 S-1594

REVISED 7/30/99 S-1594
Date: 7/11/90 Job No. 90.701

YD-48

004-1176

7D-48A