

REGISTERED PROFESSIONAL LAND SURVEYOR  
LAKE GENEVA, WISCONSIN


A parcel of land located in  
Section 1, T 2 N, R 16 E,  
Walworth County, Wisconsin.

Accuracy: Distances  $\pm .01$   
Angles  $\pm .05''$

Error of Closure less than 1/3000.



φ - IRON PIPE FOUND  
 O - IRON PIPE PLACED  
 ● - CONCRETE MONUMENT  
 x - SPIKE  
 ( ) - AS PLATTED

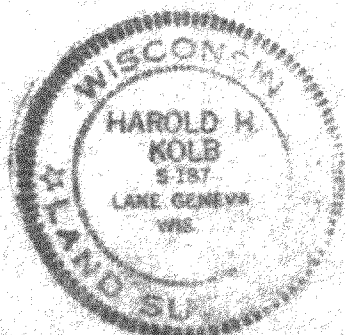

I, HAROLD H. KOLB, DO HEREBY CERTIFY THAT I HAVE SURVEYED THE PROPERTY HEREON DESCRIBED ACCORDING TO THE OFFICIAL RECORDS, AND THAT THE PLAT HEREON IS A CORRECT REPRESENTATION OF THE LOT LINES.

*Harold H. Kolb*  
HAROLD H. KOLB  
WISCONSIN REGISTERED LAND SURVEYOR, S-187  
DATE *Sept. 9, 1974*

