
## **PLAT OF SURVEY**

LOT 41, HARVEST POINTE, being a part of Lot 4 of Certified Survey Map No. 2083, and a part of the Northeast ¼, Northwest ¼, Southeast ¼ and the Southwest ¼ of the Southwest ¼ of Section 30, Town 3 North, Range 17 East, City of Elkhorn, Walworth County, Wisconsin.

Surveyed for: Bielinski Brothers Builders/ Thomas and Sandra Beinert

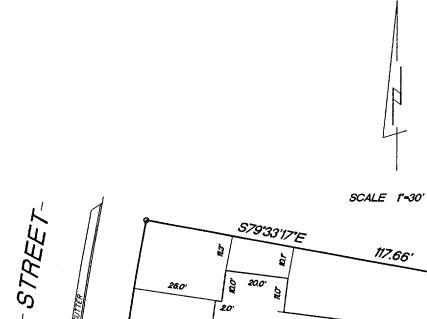


STON MADE CHANNICE AND PLITTY ENSERBITY

SO MADE CHANNICE AND PLITTY ENSER ENTER ENTER ENTER ENTER ENTER ENTER ENTER ENTER ENTER ENTER

## • FOUND 1' IRON PIPE

| RADIUS  | LENGTH | CHORD  | BEARING     | DELTA   |
|---------|--------|--------|-------------|---------|
| 767.00' | 88.31  | 88.26" | NO7'08'48'E | 063548' |

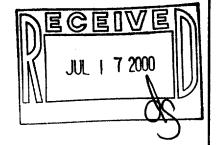

"I hereby certify that I have surveyed the above described roperty and that the above map is a true representation thereof and shows the size and location of the property, its exterior coundaries, the location of all visible structures and dimension of all principal buildings thereon, boundary fences, apparent assements, roadways and encroachments if any."

"This survey is made for the use of the present owners of the croperty, and also those who purchase, mortgage or guarantee the title thereto within one year from date hereof."

REV. 5/16/00 TEP/DW

DATE FIELD WORK BY

KETTLE MORAINE SURVEYING W356 S9050 Godfrey Lane Eagle Wisconsin 53119 P.O. Box 357 (262) 594-3484 Terrance E. Pisarek R.L.S.

THIS IS NOT AN ORIGINAL SURVEY UNLESS THE SEAL IS RED

 TEP
 00099

 DRAWN BY
 JOB NUMBER

14-9HK

8461-1248