


• Iron stake

NORTH WASHINGTON STREET

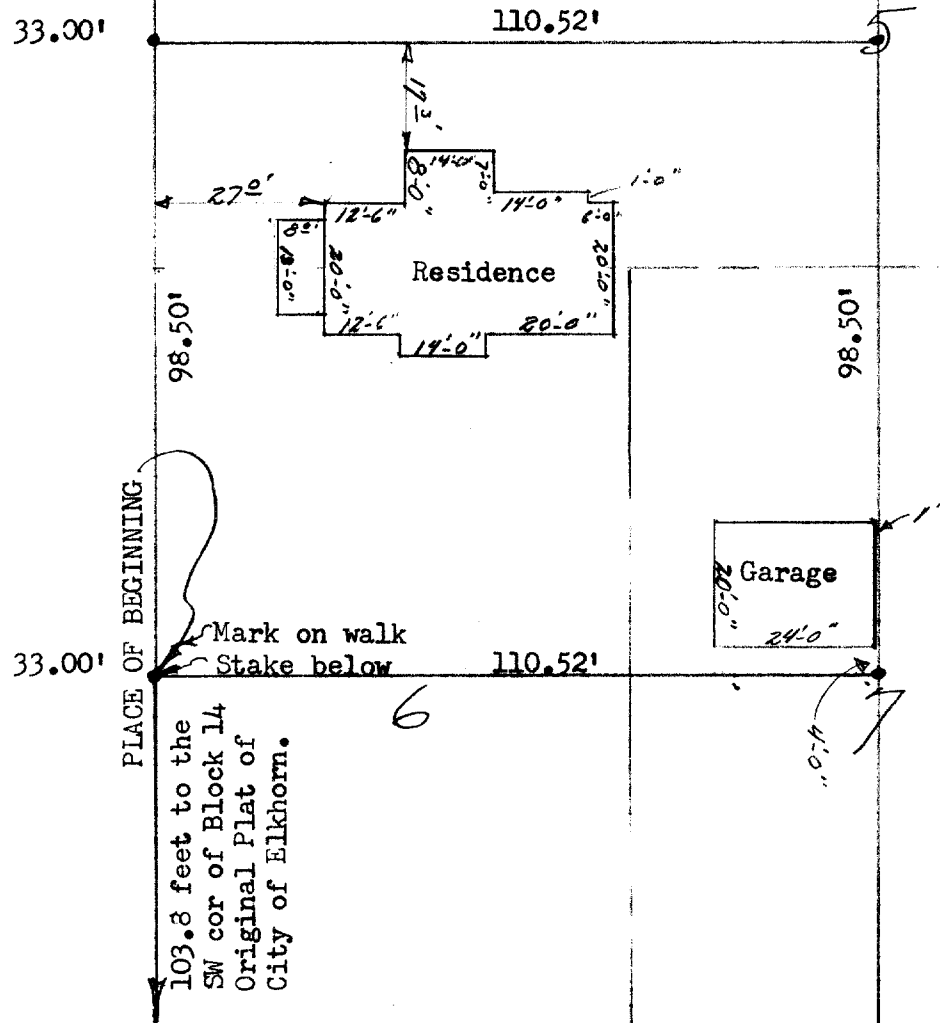

DESCRIPTION: Beginning at a point on the West line of Block 14 of the Original Plat of the City of Elkhorn, Walworth County, Wisconsin, 103.8 feet North of the S.W. corner of said block, running thence East on a line parallel with the South line of said block 110.52 feet more or less to the North and South centerline of said block and parallel with the West line of said block 98.5 feet more or less to the S.E. corner of lands heretofore conveyed by Lizzie Townsend, Louisa Flett and Lena Townsend to George Farrar, in deed dated July 14th 1887, and recorded September 27th, 1887 in the office of the Register of Deeds for Walworth County, State of Wisconsin, in Volume 74 of Deeds on Page 463, running thence West parallel with said first mentioned line and on the South line of said premises heretofore conveyed to George Farrar to the West line of said block running thence South on the West line of said block 98.5 feet more or less to the place of beginning, containing one quarter of an acre more or less.

CERTIFICATE: I, James F. Biagi, Surveyor do hereby certify that I have surveyed the property hereon described and that the location of the improvements are as shown.

*James F. Biagi*  
James F. Biagi R.L.S. 272  
Elkhorn, Wisconsin.

Dated: June 25th 1965.

4-126B