

AMERICAN SURVEYING COMPANY, INC.

LAND SURVEYORS

12207 C.T.H. "K" FRANKSVILLE, WISCONSIN 53126
TEL. (262) 835-4774 FAX: (262) 835-2379


PLAT OF SURVEY

PREPARED FOR: PEMBROOKE HOMES, LLC

OWNERS: PEMBROOKE, MODEL

DESCRIPTION:

LOT 51 OF "ELKHORN WEST", LOCATED IN THE NORTHEAST 1/4 OF THE SOUTHEAST 1/4 AND THE THE SOUTHEAST 1/4 OF THE SOUTHEAST 1/4 OF SECTION 35, TOWN 3 NORTH, RANGE 16 EAST, AND IN THE NORTHEAST 1/4 OF SECTION 2, TOWN 2 NORTH, RANGE 16 EAST, IN THE CITY OF ELKHORN, COUNTY OF WALWORTH, STATE OF WISCONSIN.


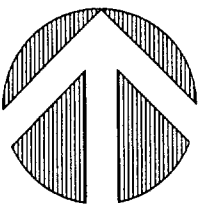


NORTH

SCALE

0 30 60

FEET

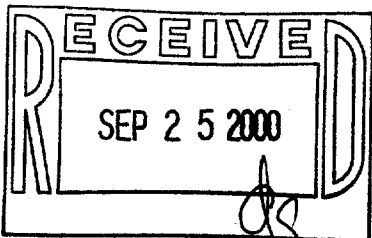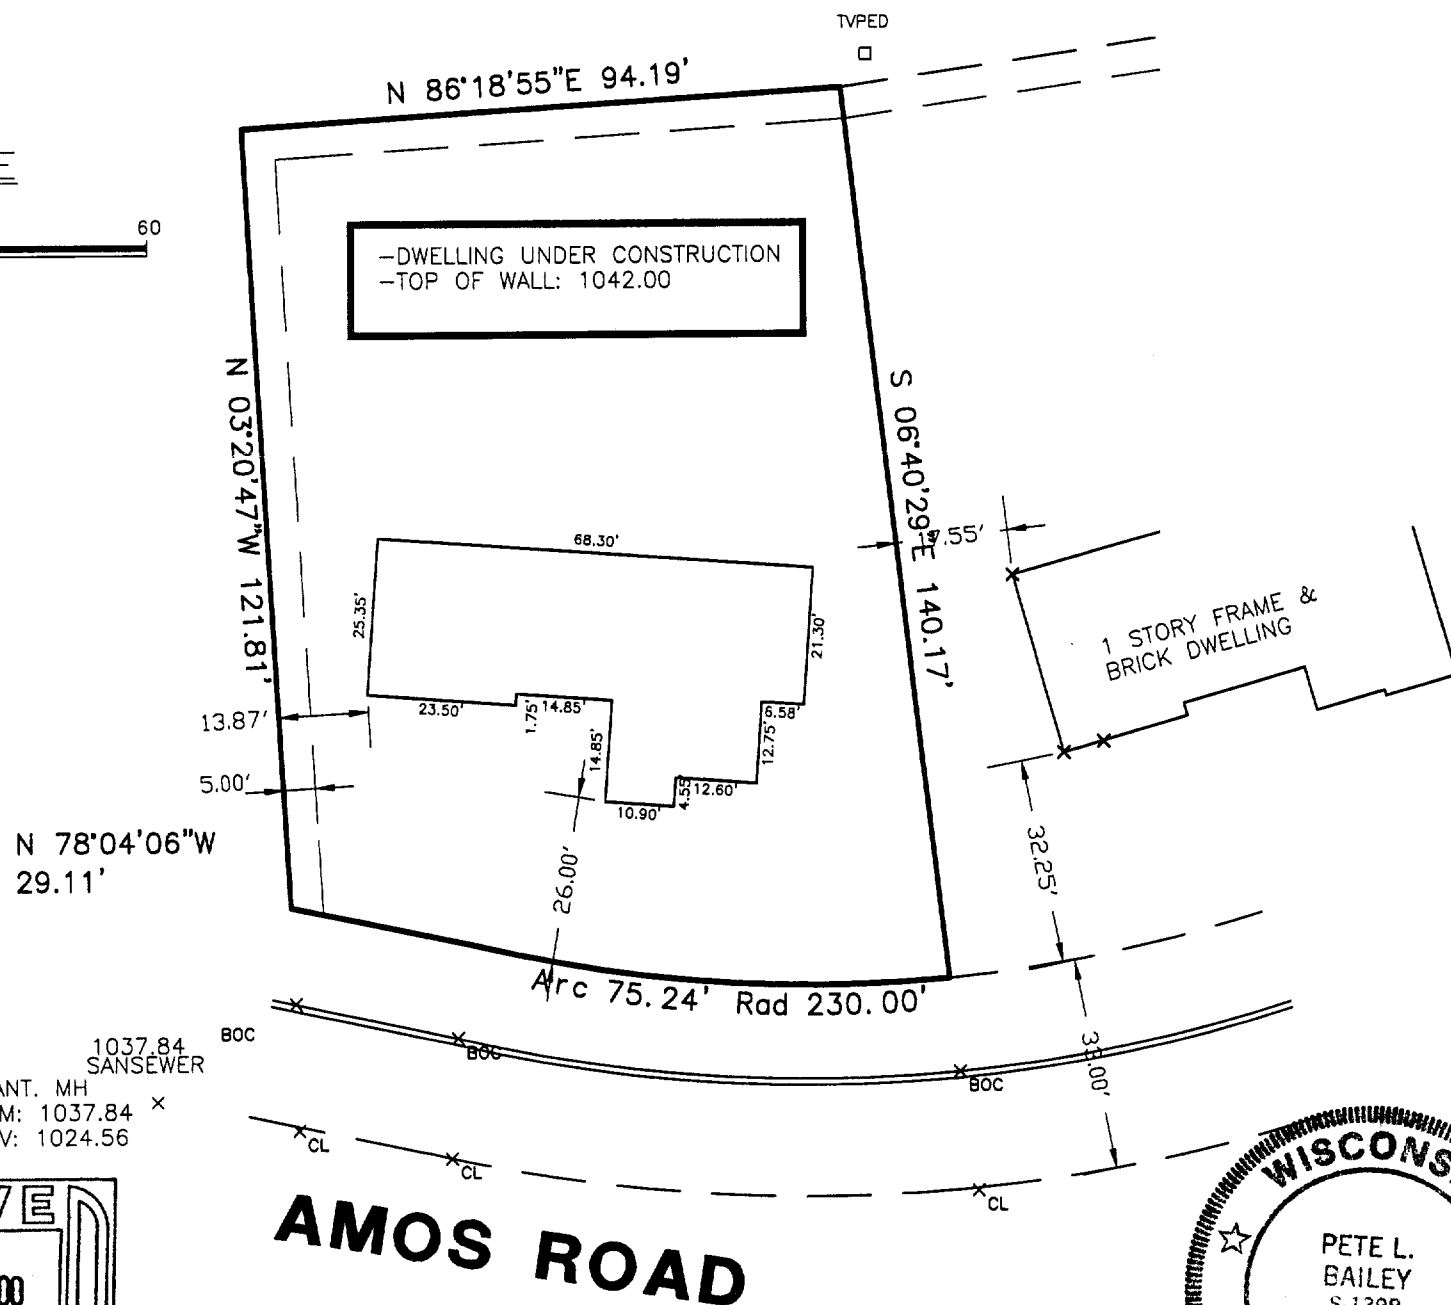

Proposed building is staked on actual corner with 6 foot offsets on the longest house line. The contractor will be responsible to field verify all stakes for location and dimension prior to construction. If any discrepancies should arise, notify this office at once.

STATE OF WISCONSIN
COUNTY OF RACINE

The above described property has been surveyed under my direction and the above map is a correct representation thereof.

Dated at North Cape, WISCONSIN this 26TH day of APRIL, 2000.

Recertified 07/21/2000

Pete L. Bailey R.L.S. 1398

DRAWN BY: PLB
CHECKED BY: PLB

JOB NO. 200085
DRAWING NAME: JN2000101

004-1289

YEW-51