



**LOT 14, HARVEST POINTE**, being a part of Lot 4 of Certified Survey Map No. 2083, and a part of the Northeast  $\frac{1}{4}$ , Northwest  $\frac{1}{4}$ , Southeast  $\frac{1}{4}$  and the Southwest  $\frac{1}{4}$  of the Southwest  $\frac{1}{4}$  of Section 30, Town 3 North, Range 17 East, City of Elkhorn, Walworth County, Wisconsin.

—MORNINGSIDE—STREET—

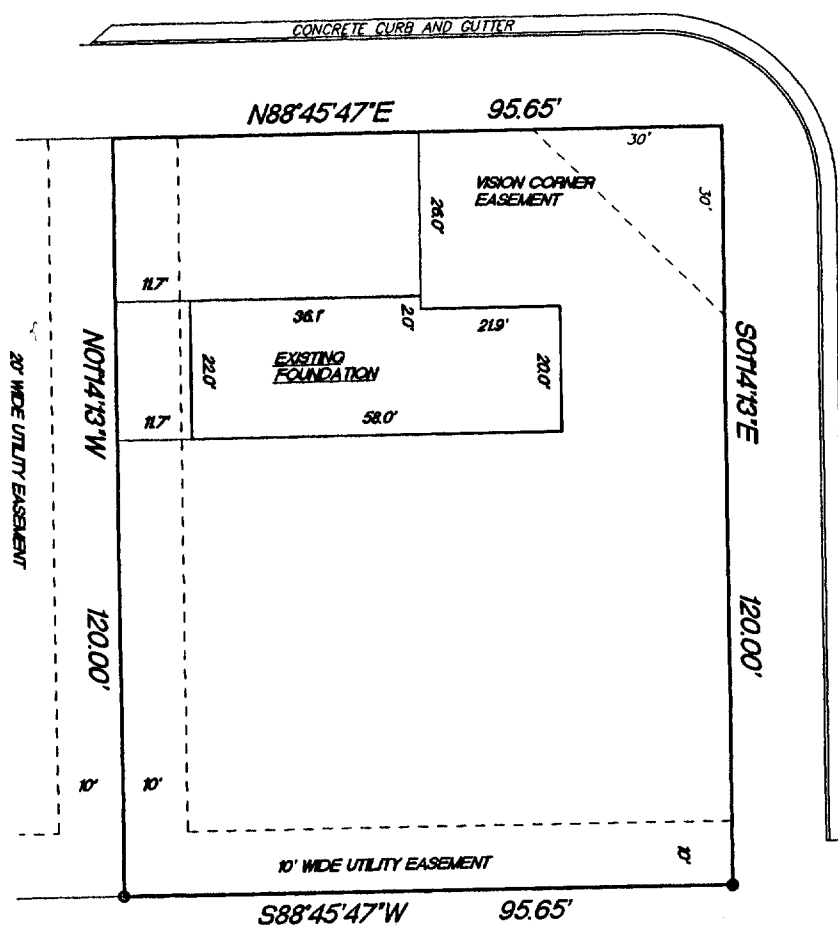

PATRICIA — STREET

- FOUND 2" IRON PIPE
- FOUND 1" IRON PIPE

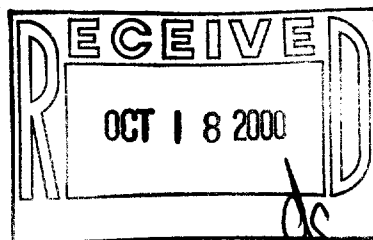

**FRONT MONUMENTATION HAS NOT  
BEEN SET BY DEVELOPER YET**

"This survey is made for the use of the present owners of the property, and also those who purchase, mortgage or guarantee the title thereto within one year from date hereof."

**Terrance E. Pisarek R.L.S.**

**THIS IS NOT AN ORIGINAL SURVEY UNLESS THE SEAL IS RED.**

REV. 8/29/00  
7/14/00

DATE \_\_\_\_\_

TEP/DW

**FIELD WORK BY**

TEP

DRAWN BY

00191

**JOB NUMBER**

УНР-14

004-1295