

PLAT OF SURVEY



LOT 6, MAPLE VIEW SUBDIVISION, located in the Northwest ¼ and the Southwest ¼ of the Northwest ¼ of Section 31, Town 3 North, Range 17 East, City of Elkhorn, Walworth County, Wisconsin.

Surveyed for: Bielinski Brothers Builders/ David and Angela Recknagel


66' WIDE

NORTH JACKSON STREET

CONCRETE CURB AND CUTTER

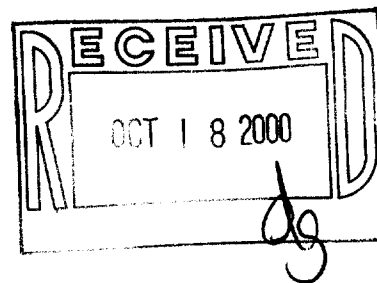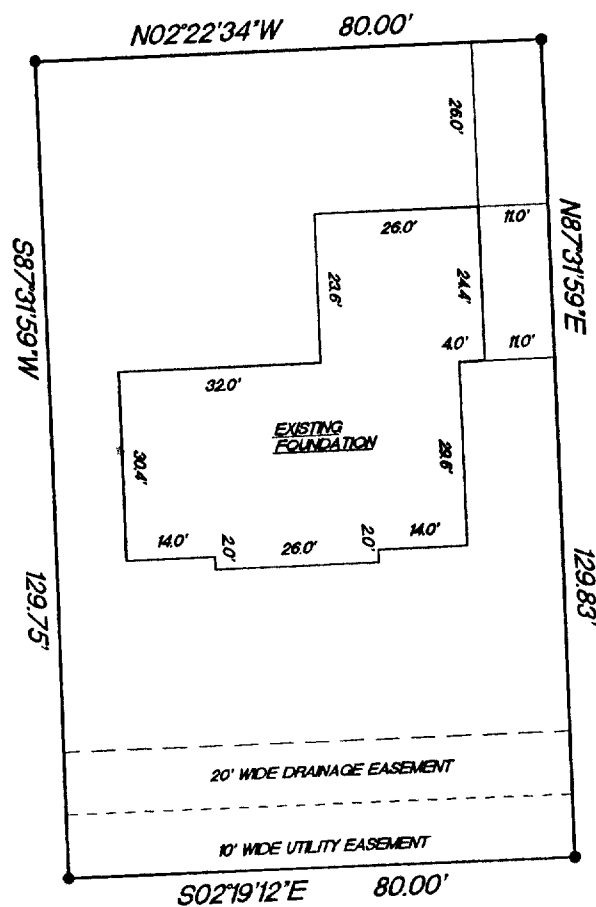

• FOUND 3/4" IRON REBAR

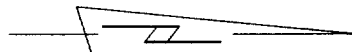

SCALE 1"=30'

"I hereby certify that I have surveyed the above described property and that the above map is a true representation thereof and shows the size and location of the property, its exterior boundaries, the location of all visible structures and dimension of all principal buildings thereon, boundary fences, apparent easements, roadways and encroachments if any."

"This survey is made for the use of the present owners of the property, and also those who purchase, mortgage or guarantee the title thereto within one year from date hereof."

KETTLE MORaine SURVEYING
W356 S9050 Godfrey Lane
Eagle Wisconsin 53119
P.O. Box 357
(262) 594-3484

Terrance E. Pisarek R.L.S.

THIS IS NOT AN ORIGINAL SURVEY UNLESS THE SEAL IS RED.

REV. 10/8/00
8/29/00

DATE

TEP/DW

FIELD WORK BY

TEP

DRAWN BY

00217

JOB NUMBER

Ymv-6

004-1302