


PLAT OF SURVEY

OF


Lot 13, Block 2 of HOLTON HEIGHTS ADDITION TO THE CITY OF ELKHORN, being a subdivision of the Northeast Quarter of the Northeast Quarter of Section 36, Township 3 North, Range 16 East of the 4th Principal Meridian, City of Elkhorn, Walworth County, Wisconsin

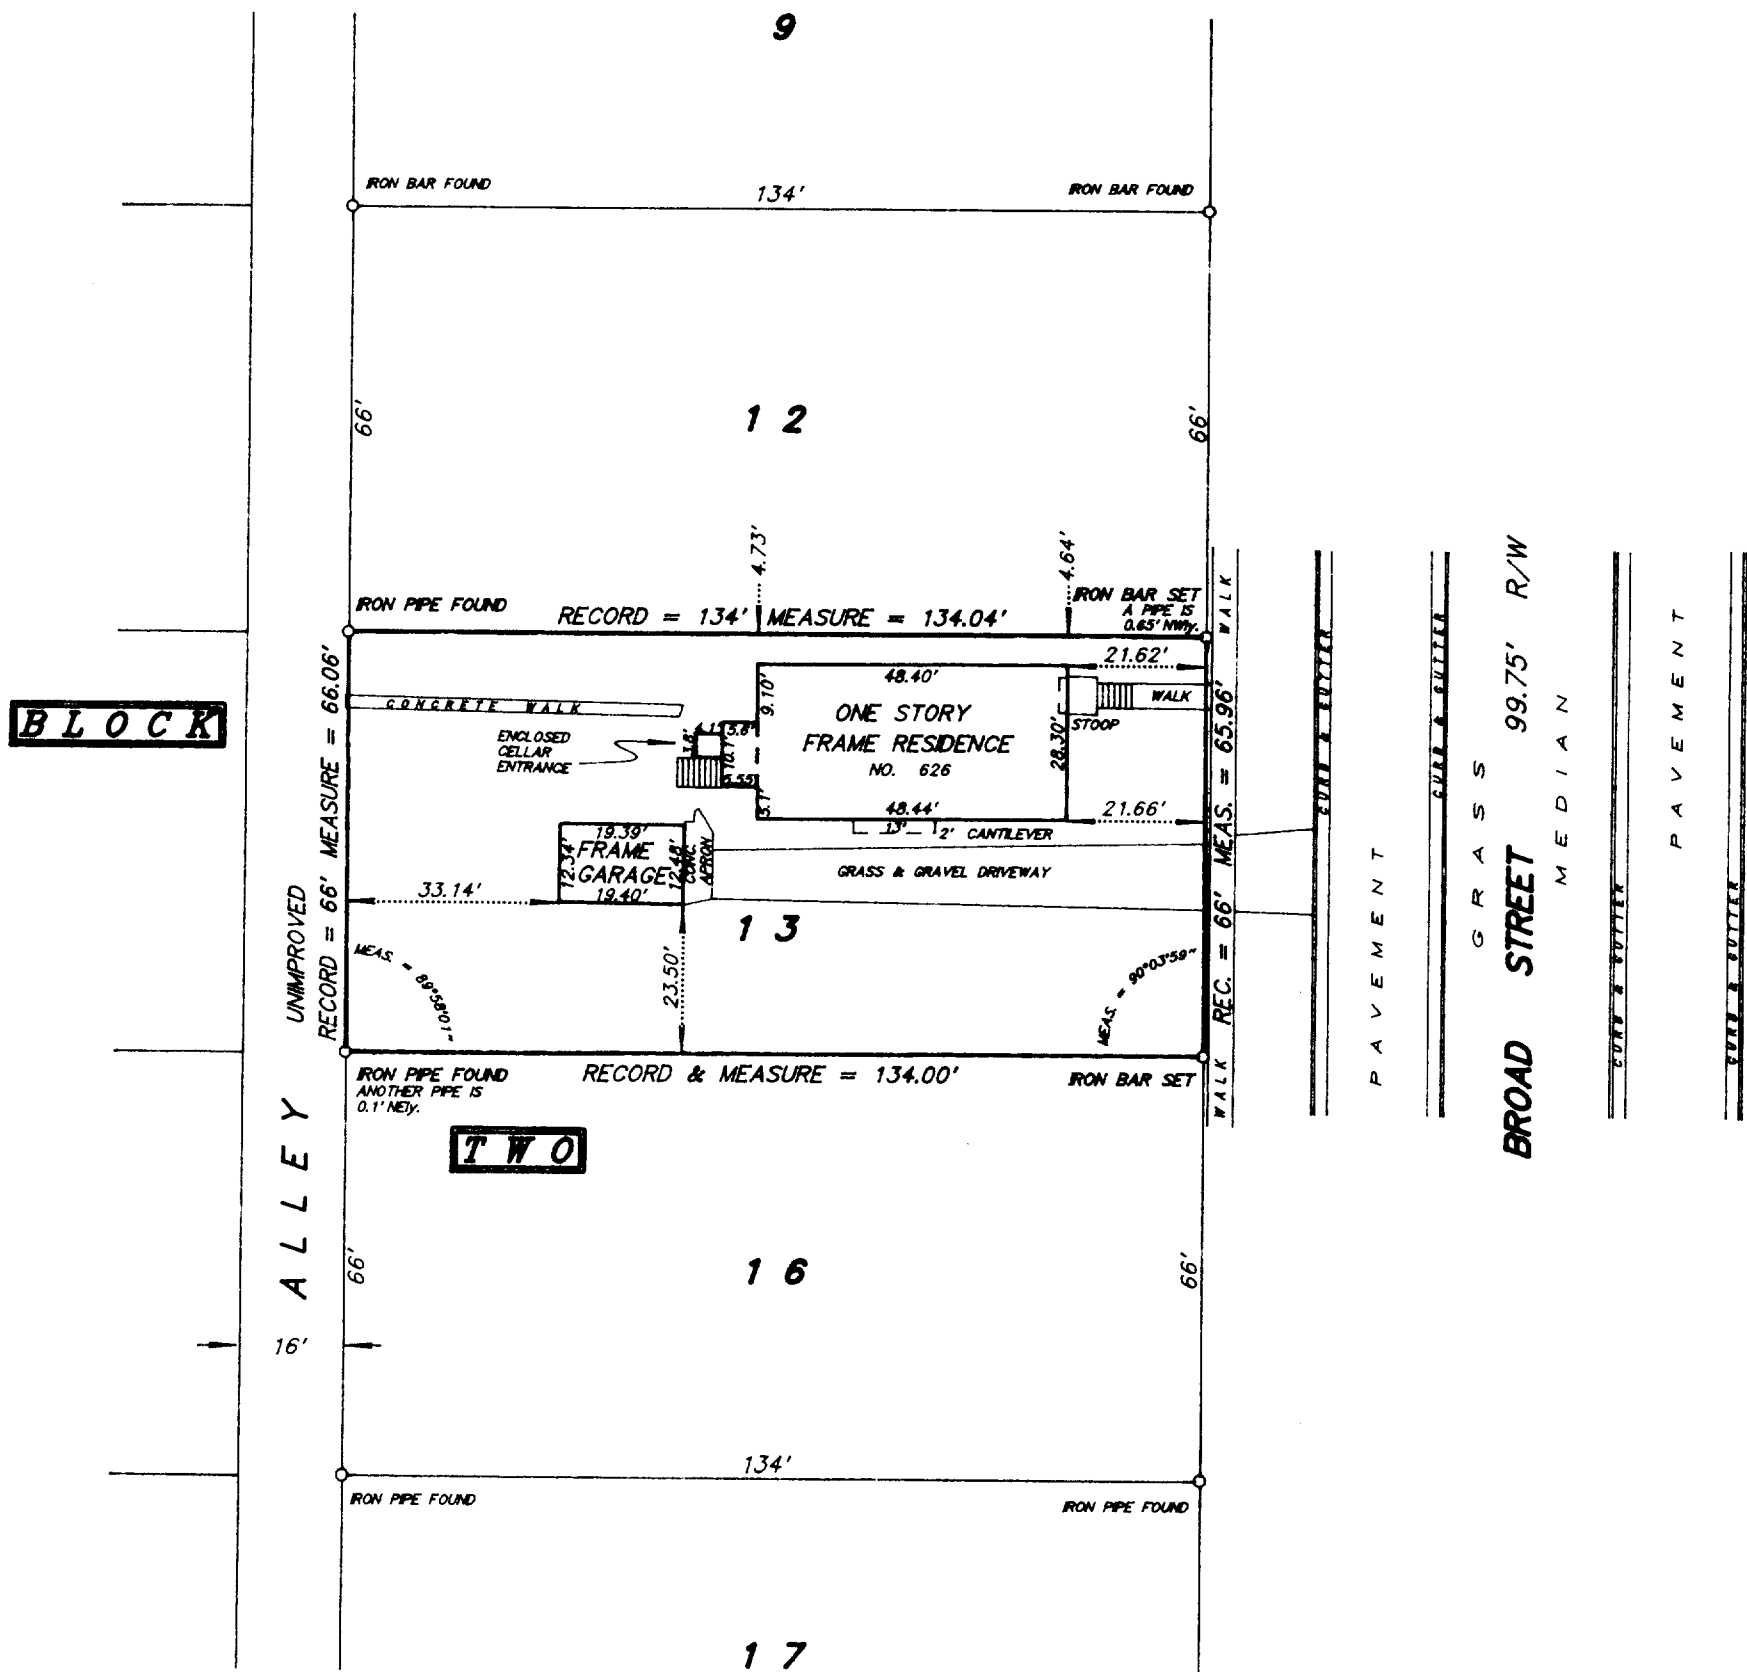

SCALE 1 inch = 30 feet

ORDERED BY M. Mathison / Coldwell Banker
Geneva Lakes Area Realtors

JOB NO. 00240

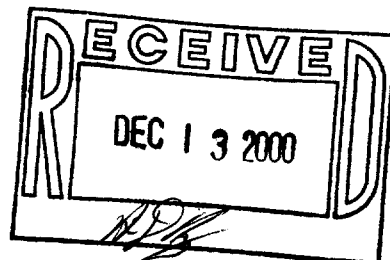

I hereby certify that I have surveyed the above described property and the above plat is a true representation thereof and shows the size and location of the property, its exterior boundaries, the location and dimensions of all visible structures thereon, boundary fences, apparent easements and roadways and visible encroachments, if any.

This survey is made for the exclusive use of the present owners of the property, and also those who purchase, mortgage, or guarantee the title thereto within one year from the date hereof.

Dated at Bassett, Wisconsin this _____ day of _____ 2000.

Mark A. Bolender
Wisconsin Registered Land Surveyor S - 1784

YHT-21V