


45-11

North Washington St.



North Lincoln St.

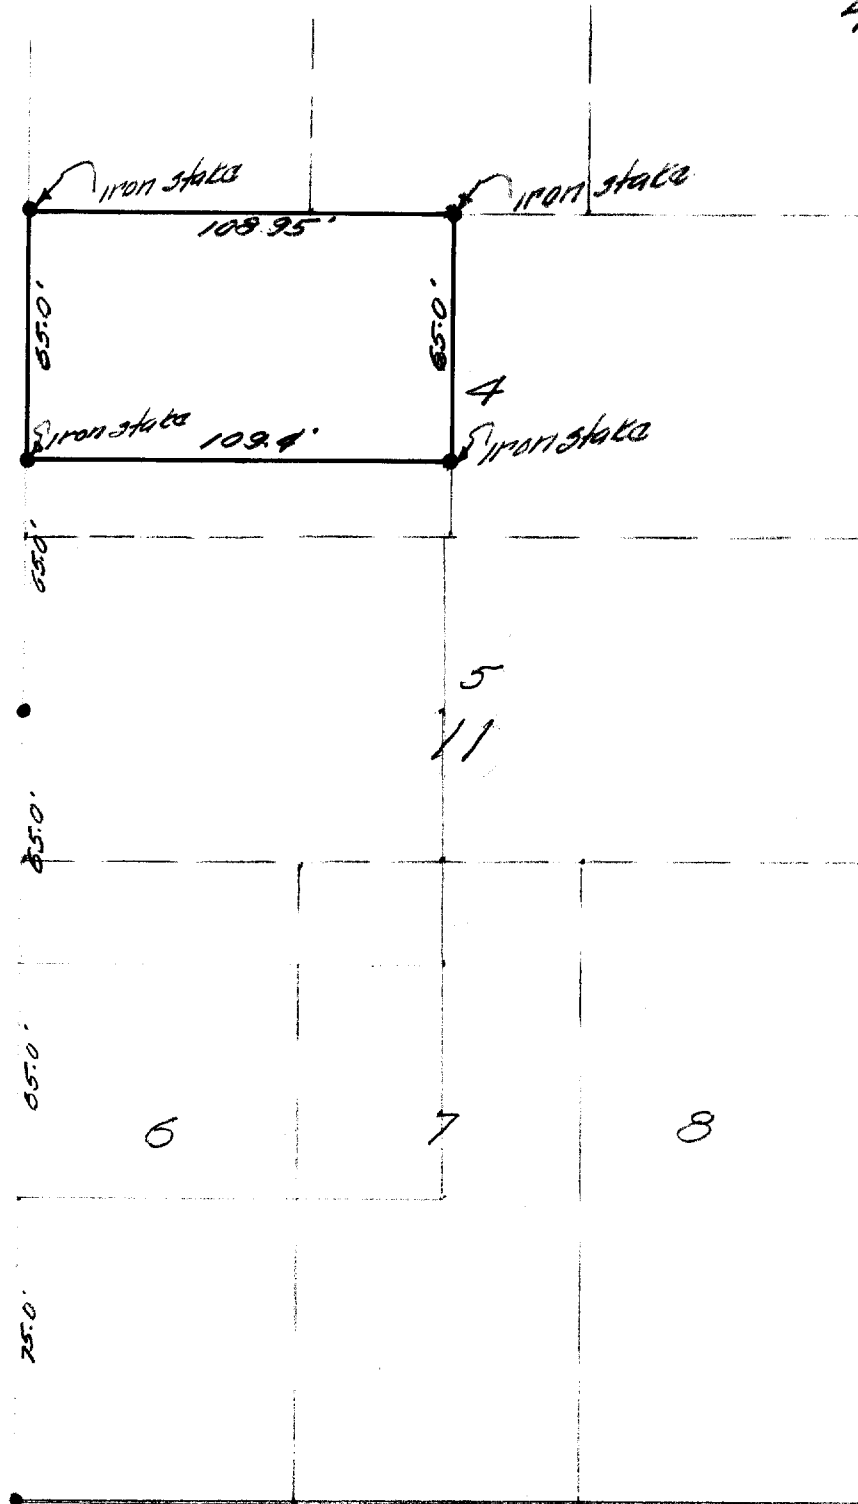

Jefferson St.

DESCRIPTION: The north 65 feet of the west one half of Lot 4 , Block 11, Original Plat of the City of Elkhorn Wisconsin.  
 CERTIFICATE: I, hereby certify that I have on this the 16th day of July, 1945, surveyed the above described property according to the official records on file in the office of the Recorder of Deeds in and for Walworth County, Wisconsin, and find that no encroachments exist and that the plat hereon portrayed is an exact reproduction of the conditions found at the site on this day.

SIGNED AND SEALED THIS 17th DAY OF JULY 1945.

Joseph M. Biagi. Professional Engineer.  
 Elkhorn Wisconsin.

pp-468A

4-131