


PLAT OF SURVEY


LOT 28, JACKSON CREEK EAST SUBDIVISION, located in the Southwest ¼ and Southeast ¼'s of the Southwest ¼ of Section 7, Town 2 North, Range 17 East, City of Elkhorn, Walworth County, Wisconsin.

Surveyed for: Bielinski Brothers Builders/ Clay and Rachel Nelson

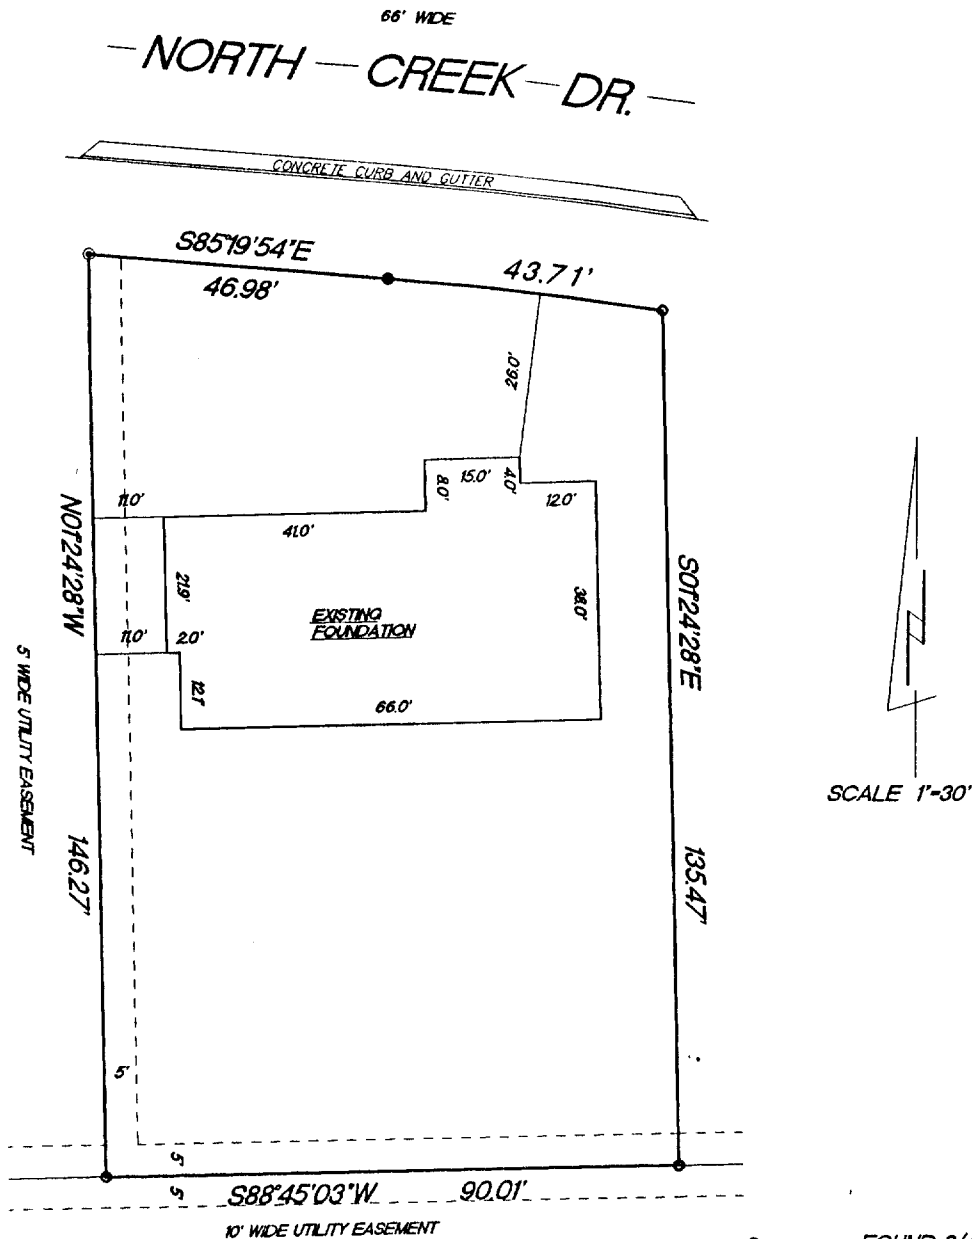

- FOUND 3/4" REBAR
- FOUND 1 5/16" REBAR
- ⊙ FOUND 1" IRON PIPE

RADIUS	LENGTH	CHORD	BEARING	DELTA
652.93'	43.71'	43.70'	N83°24'49.5"W	03°50'09"

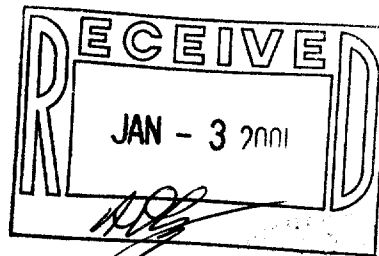

"I hereby certify that I have surveyed the above described property and that the above map is a true representation thereof and shows the size and location of the property, its exterior boundaries, the location of all visible structures and dimension of all principal buildings thereon, boundary fences, apparent easements, roadways and encroachments if any."

"This survey is made for the use of the present owners of the property, and also those who purchase, mortgage or guarantee the title thereto within one year from date hereof."

KETTLE MORaine SURVEYING
W356 S9050 Godfrey Lane
Eagle Wisconsin 53119
P.O. Box 357
(262) 594-3484

Terrance E. Pisarek R.L.S.

THIS IS NOT AN ORIGINAL SURVEY UNLESS THE SEAL IS RED.

REV. 12/15/00
11/13/00

DATE

TEP/DW

FIELD WORK BY

TEP

DRAWN BY

00296

JOB NUMBER

YJCE-28

004-1313