


WESTWARD DRIVE

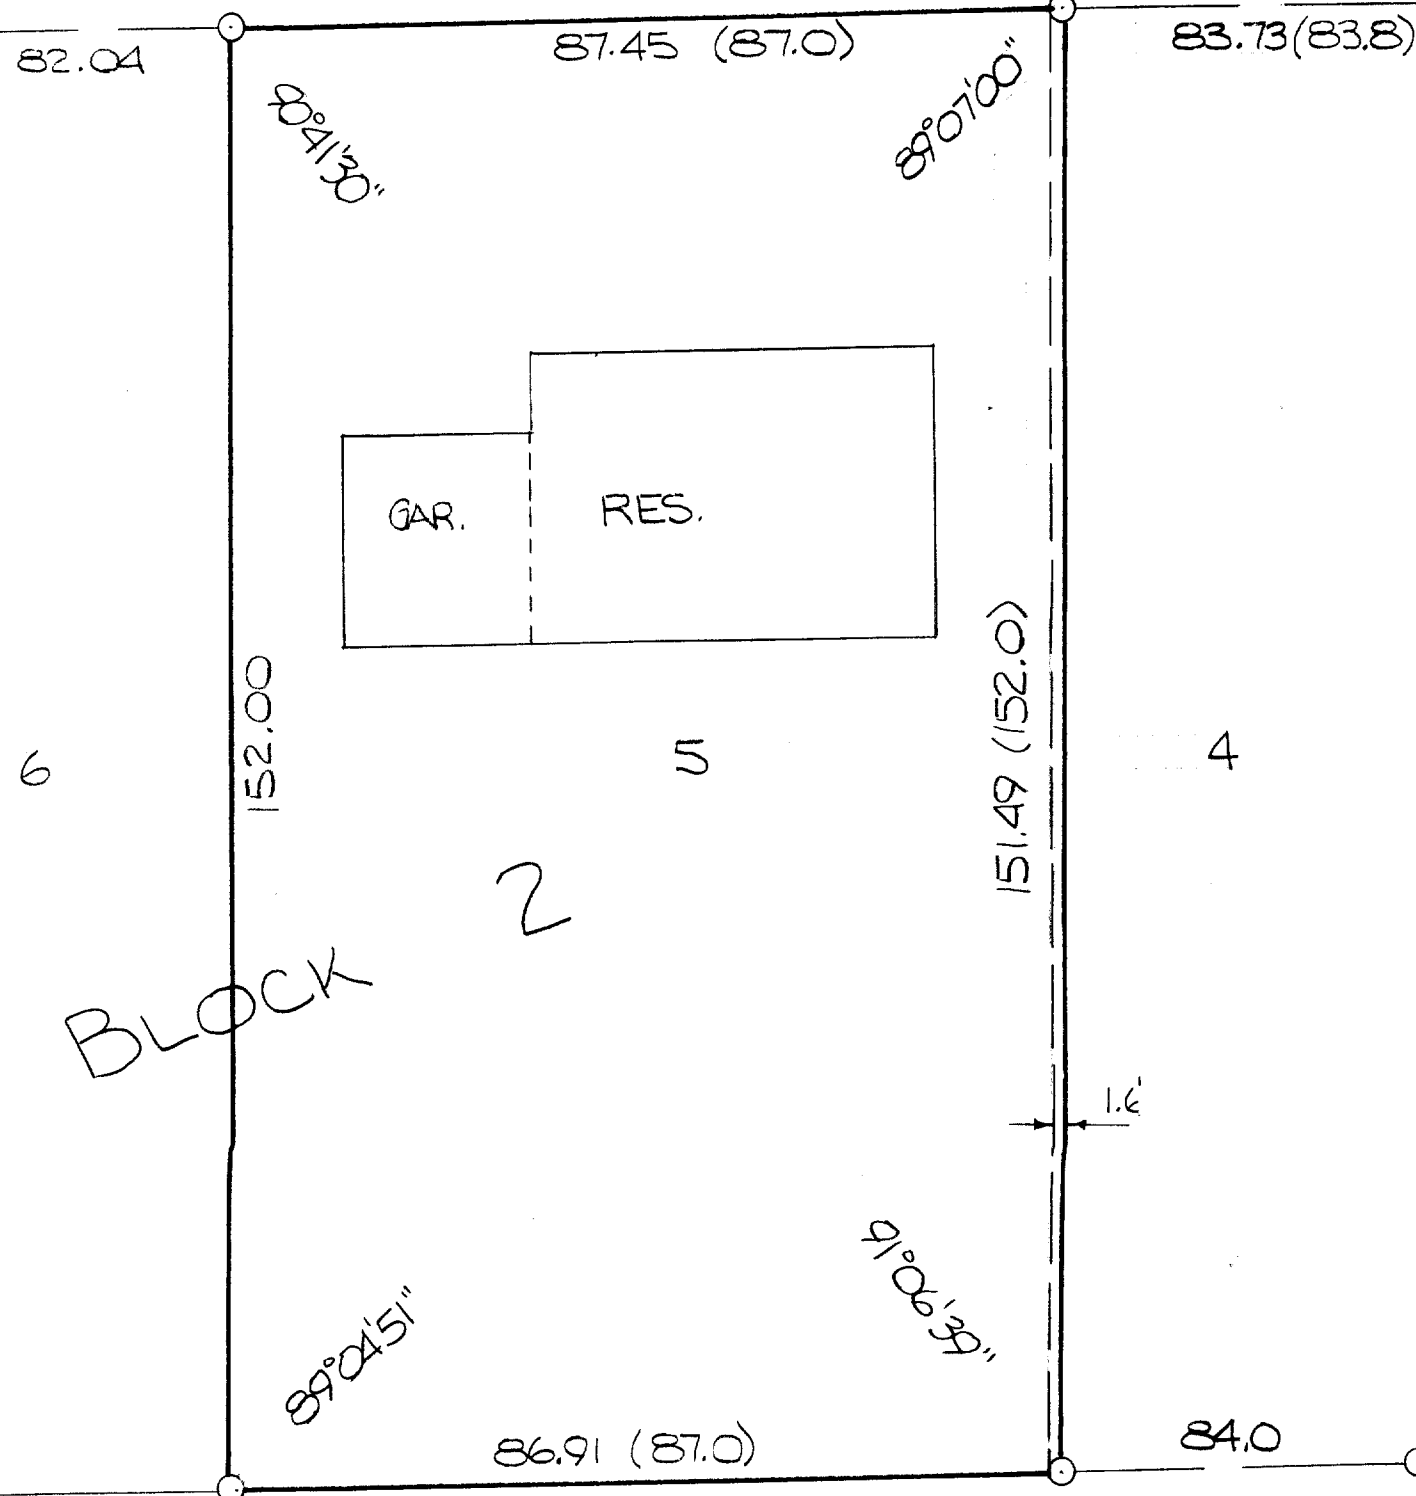

○ - IRON PIPE FOUND
() - RECORDED AS




DESCRIPTION:

ALL OF LOT 5 AND THE WEST 1.6 FEET OF LOT 4 ALL IN BLOCK 2 OF JAMES JONES 2ND ADDITION; A SUBDIVISION LOCATED IN THE CITY OF ELKHORN, WASHINGTON COUNTY, WISCONSIN

CERTIFICATE:

I, JOSEPH M. BIAGI, SURVEYOR, DO HEREBY CERTIFY THAT I HAVE SURVEYED THE LANDS HEREON DESCRIBED.

DATE:
JUNE 4, 1975

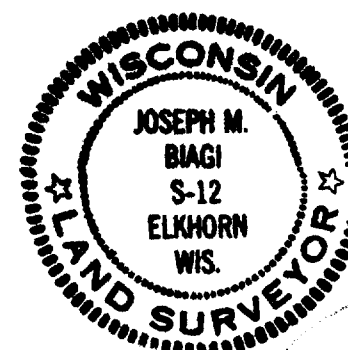

Joseph M. Biagi
JOSEPH M. BIAGI S-12

REVISIONS			DELOME GRAY		
NO.	DATE	BY			
1			LOT 5 & W 1.6' LOT 4 BLK 2 J. JONES 2ND		
2					
3					
4					
5					
			DRAWN BY	SCALE	MATERIAL
			GW	1"=20'	
			CHK'D	DATE	DRAWING NO.
				6/4/75	57-75
			TRACED	APP'D	4-123