



DEVENDORF STREET.

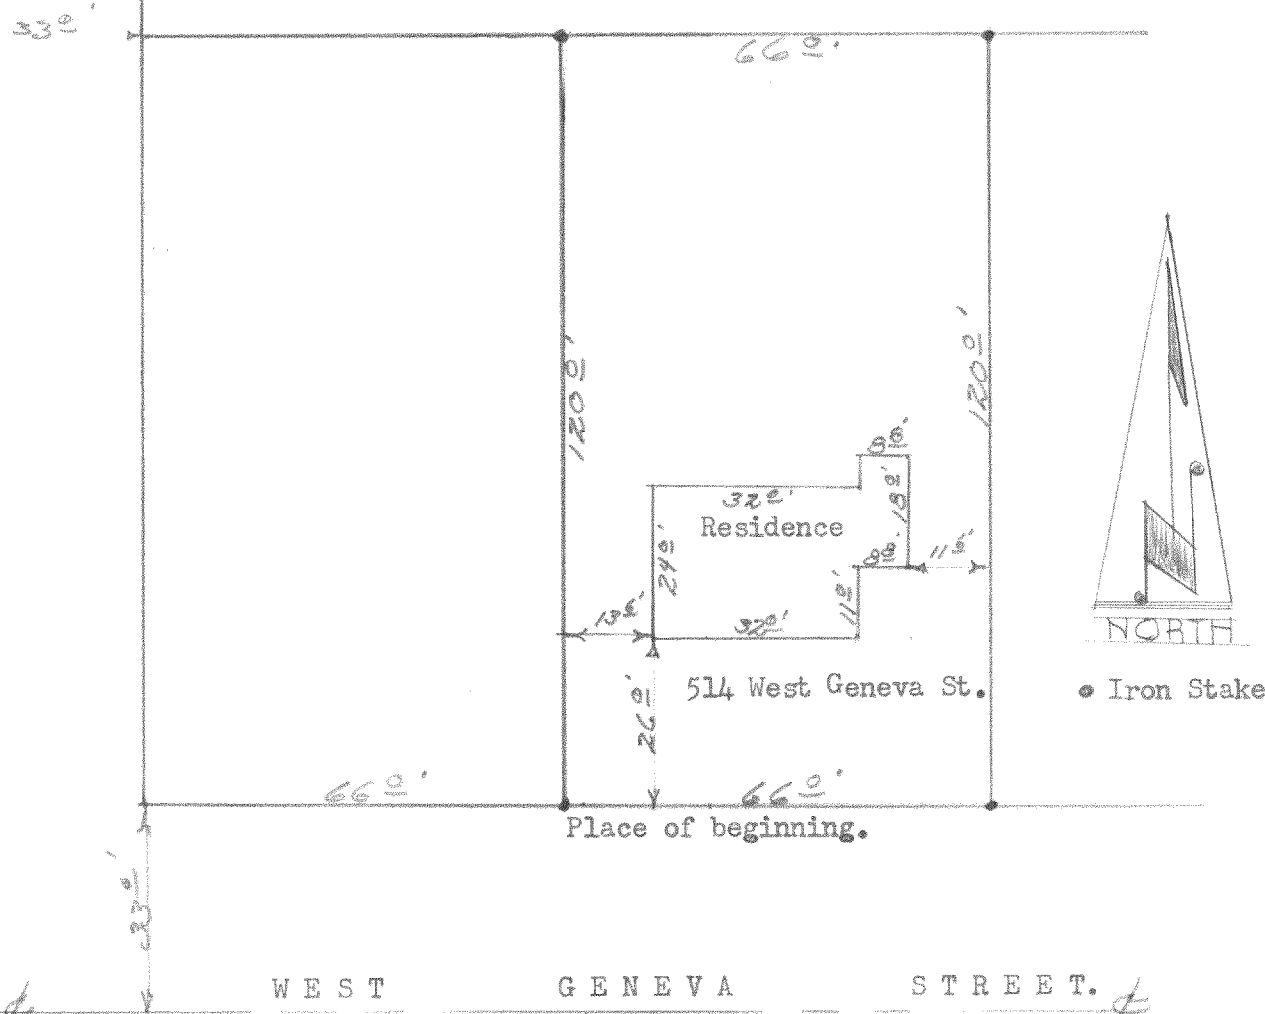

DESCRIPTION: Commencing at a point in the north line of West Geneva Street 66.00 feet east of an iron stake at the intersection of said north line and the east line of Devendorf Street in the City of Elkhorn Walworth County, Wisconsin; go thence north parallel to the east line of Devendorf Street, 120 feet; go thence east parallel to the north line of West Geneva Street 66.00 feet, go thence south parallel to the east line of Devendorf Street 120.00 feet in the northerly line of West Geneva Street, go thence west along the northerly line of West Geneva Street, 66.00 feet to the place of beginning.

CERTIFICATE: I, James F. Biagi, Surveyor do hereby certify that I have surveyed the property hereon described and that the location of the improvements are as shown.

Dated: July 23rd 1965.

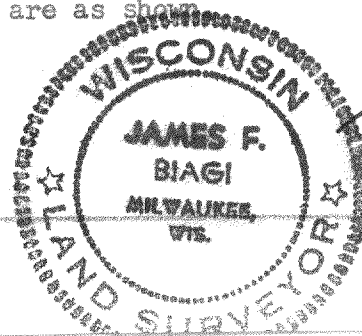

James F. Biagi, RLS 272  
Elkhorn, Wisconsin.