


PLAT OF SURVEY

LOT 17, OAKWOOD SUBDIVISION LOCATED IN THE
NORTHEAST 1/4 OF THE NORTHWEST 1/4 OF
SECTION 8, TOWNSHIP 2 NORTH, RANGE 17 EAST,
WALWORTH COUNTY, WISCONSIN.


SURVEY FOR: BOB RIGGS CONSTRUCTION
SURVEY ADDRESS: 1201 OAKWOOD LANE

NOTE: PROPOSED ADDITION TO BE STAKED BY OTHERS

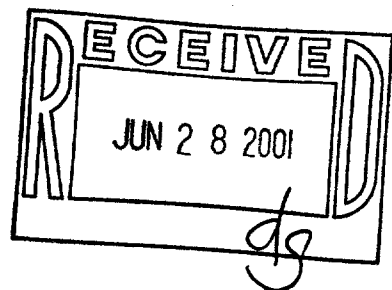


"I hereby certify that I have surveyed the above described property and that the above map is a correct representation thereof and shows the size and location of the property, its exterior boundaries, the location of all visible structures and dimensions of all principal buildings thereon, boundary fences, apparent easements, roadways and encroachments, if any."

"This survey is made for the use of the present owners of the property, and those who purchase, mortgage, or guarantee the title thereto within one year from date hereof."

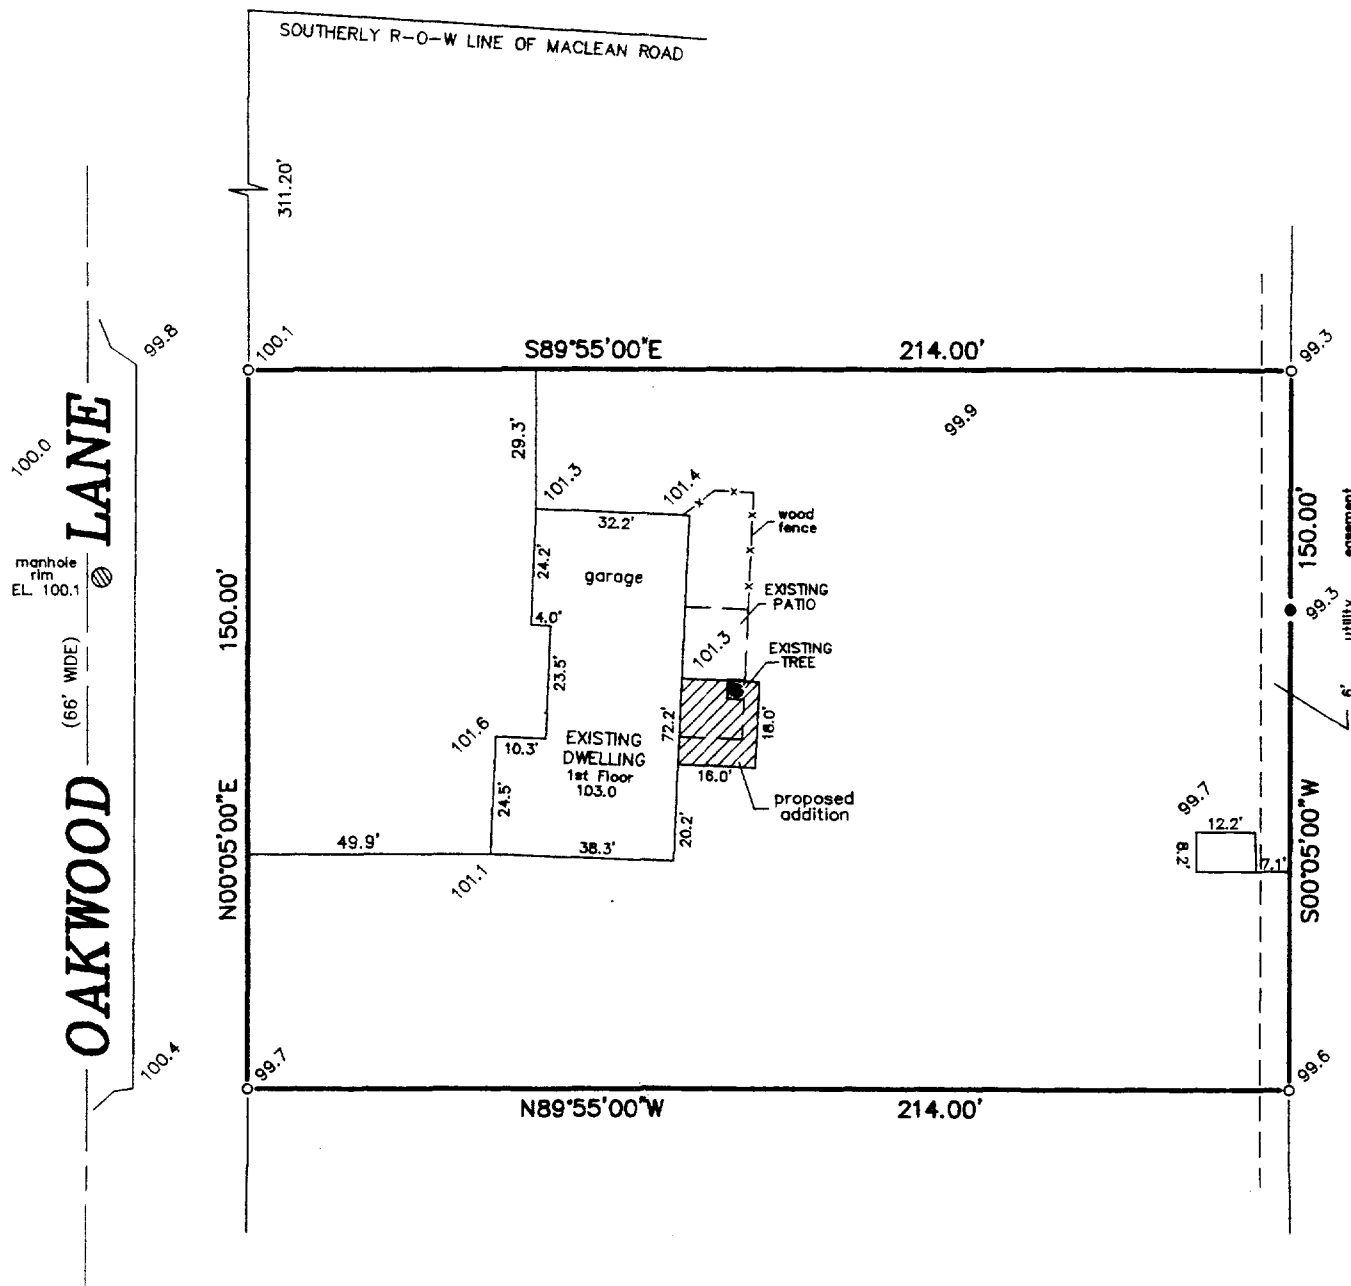

SCALE: 1" = 40'

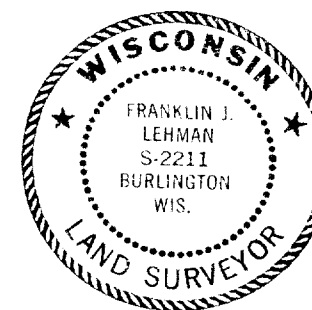


THIS IS NOT AN ORIGINAL PRINT
UNLESS THIS SEAL IS RED.

LEGEND

- FOUND IRON ROD
- FOUND IRON PIPE
- 100.0 EXISTING ELEVATION

B.W. SURVEYING, INC.

LAND SURVEYS
MAPPING AND PLANNING
412 N. PINE STREET
BURLINGTON, WI 53105
(262)-767-0225

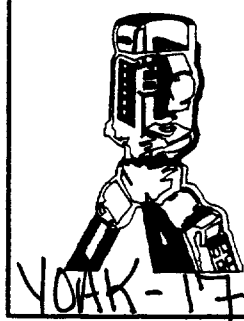

004-1383

Franklin J. Lehman
FRANKLIN J. LEHMAN S-2211

MAY 30, 2001 DATE 4995 JOB NUMBER