FARRIS, HANSEN & ASSOCIATES, INC.


ENGINEERING - ARCHITECTURE - SURVEYING 7 RIDGWAY COURT - P.O. BOX 437 - ELKHORN, WISCONSIN 53121 PHONE: (262) 723-2098 FAX: (262) 723-5886

PLAT OF SURVEY

LOCATED IN THE NE 1/4 OF SECTION 36 TOWN 3 NORTH, RANGE 16 EAST CITY OF ELKHORN, WALWORTH COUNTY, WISCONSIN - WORK ORDERED BY -JOHN JAHNS N4979 BOWERS ROAD ELKHORN, WI 53121

LEGAL DESCRIPTION OF RECORD

Commencing at a point One Thousand Seven Hundred and Eighty-eight (1788) feet South of the Northeast corner of the West One-half (1/2) of the Northeast One-quarter (1/4) of Section Thirty-six (36), Township Three (3) North, Range Sixteen (16) East, in the City of Elkhorn, County of Walworth, State of Wisconsin, which point is the Southeast corner

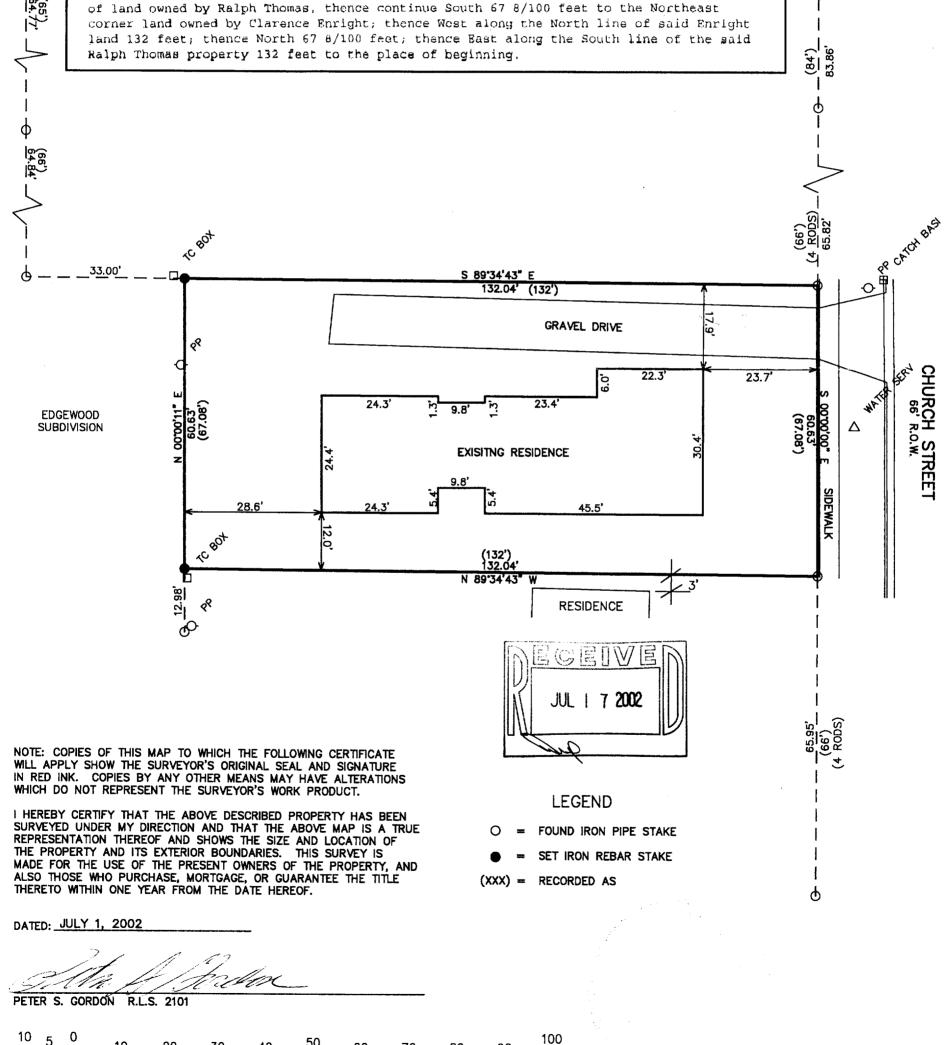

80

90

50

004-1481

PROJECT: 6063

DATE: 06/27/02 SHEET 1 OF 1

CF 60 7 WY

10

20

30

MAP SCALE IN FEET