



✓ YA 2118 -1

Plat of Survey



of

Lot 1 of Certified Survey Map No. 2118,
recorded in Vol. 10 of Certified Survey Maps of Walworth County
on Page 125 and located in the Northwest 1/4 of Section 1, Town 2
North, Range 16 East, City of Elkhorn, Walworth County, Wisconsin.

Surveyed for: **The Rauland Agency, Inc.**
118 Kenosha Street • P.O. Box 159
Walworth, Wisconsin. 53184

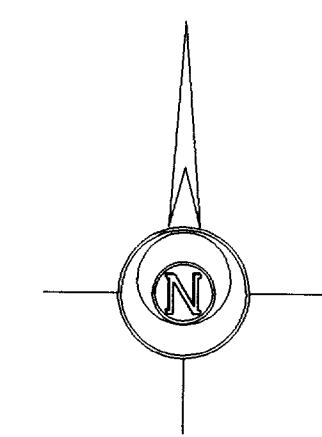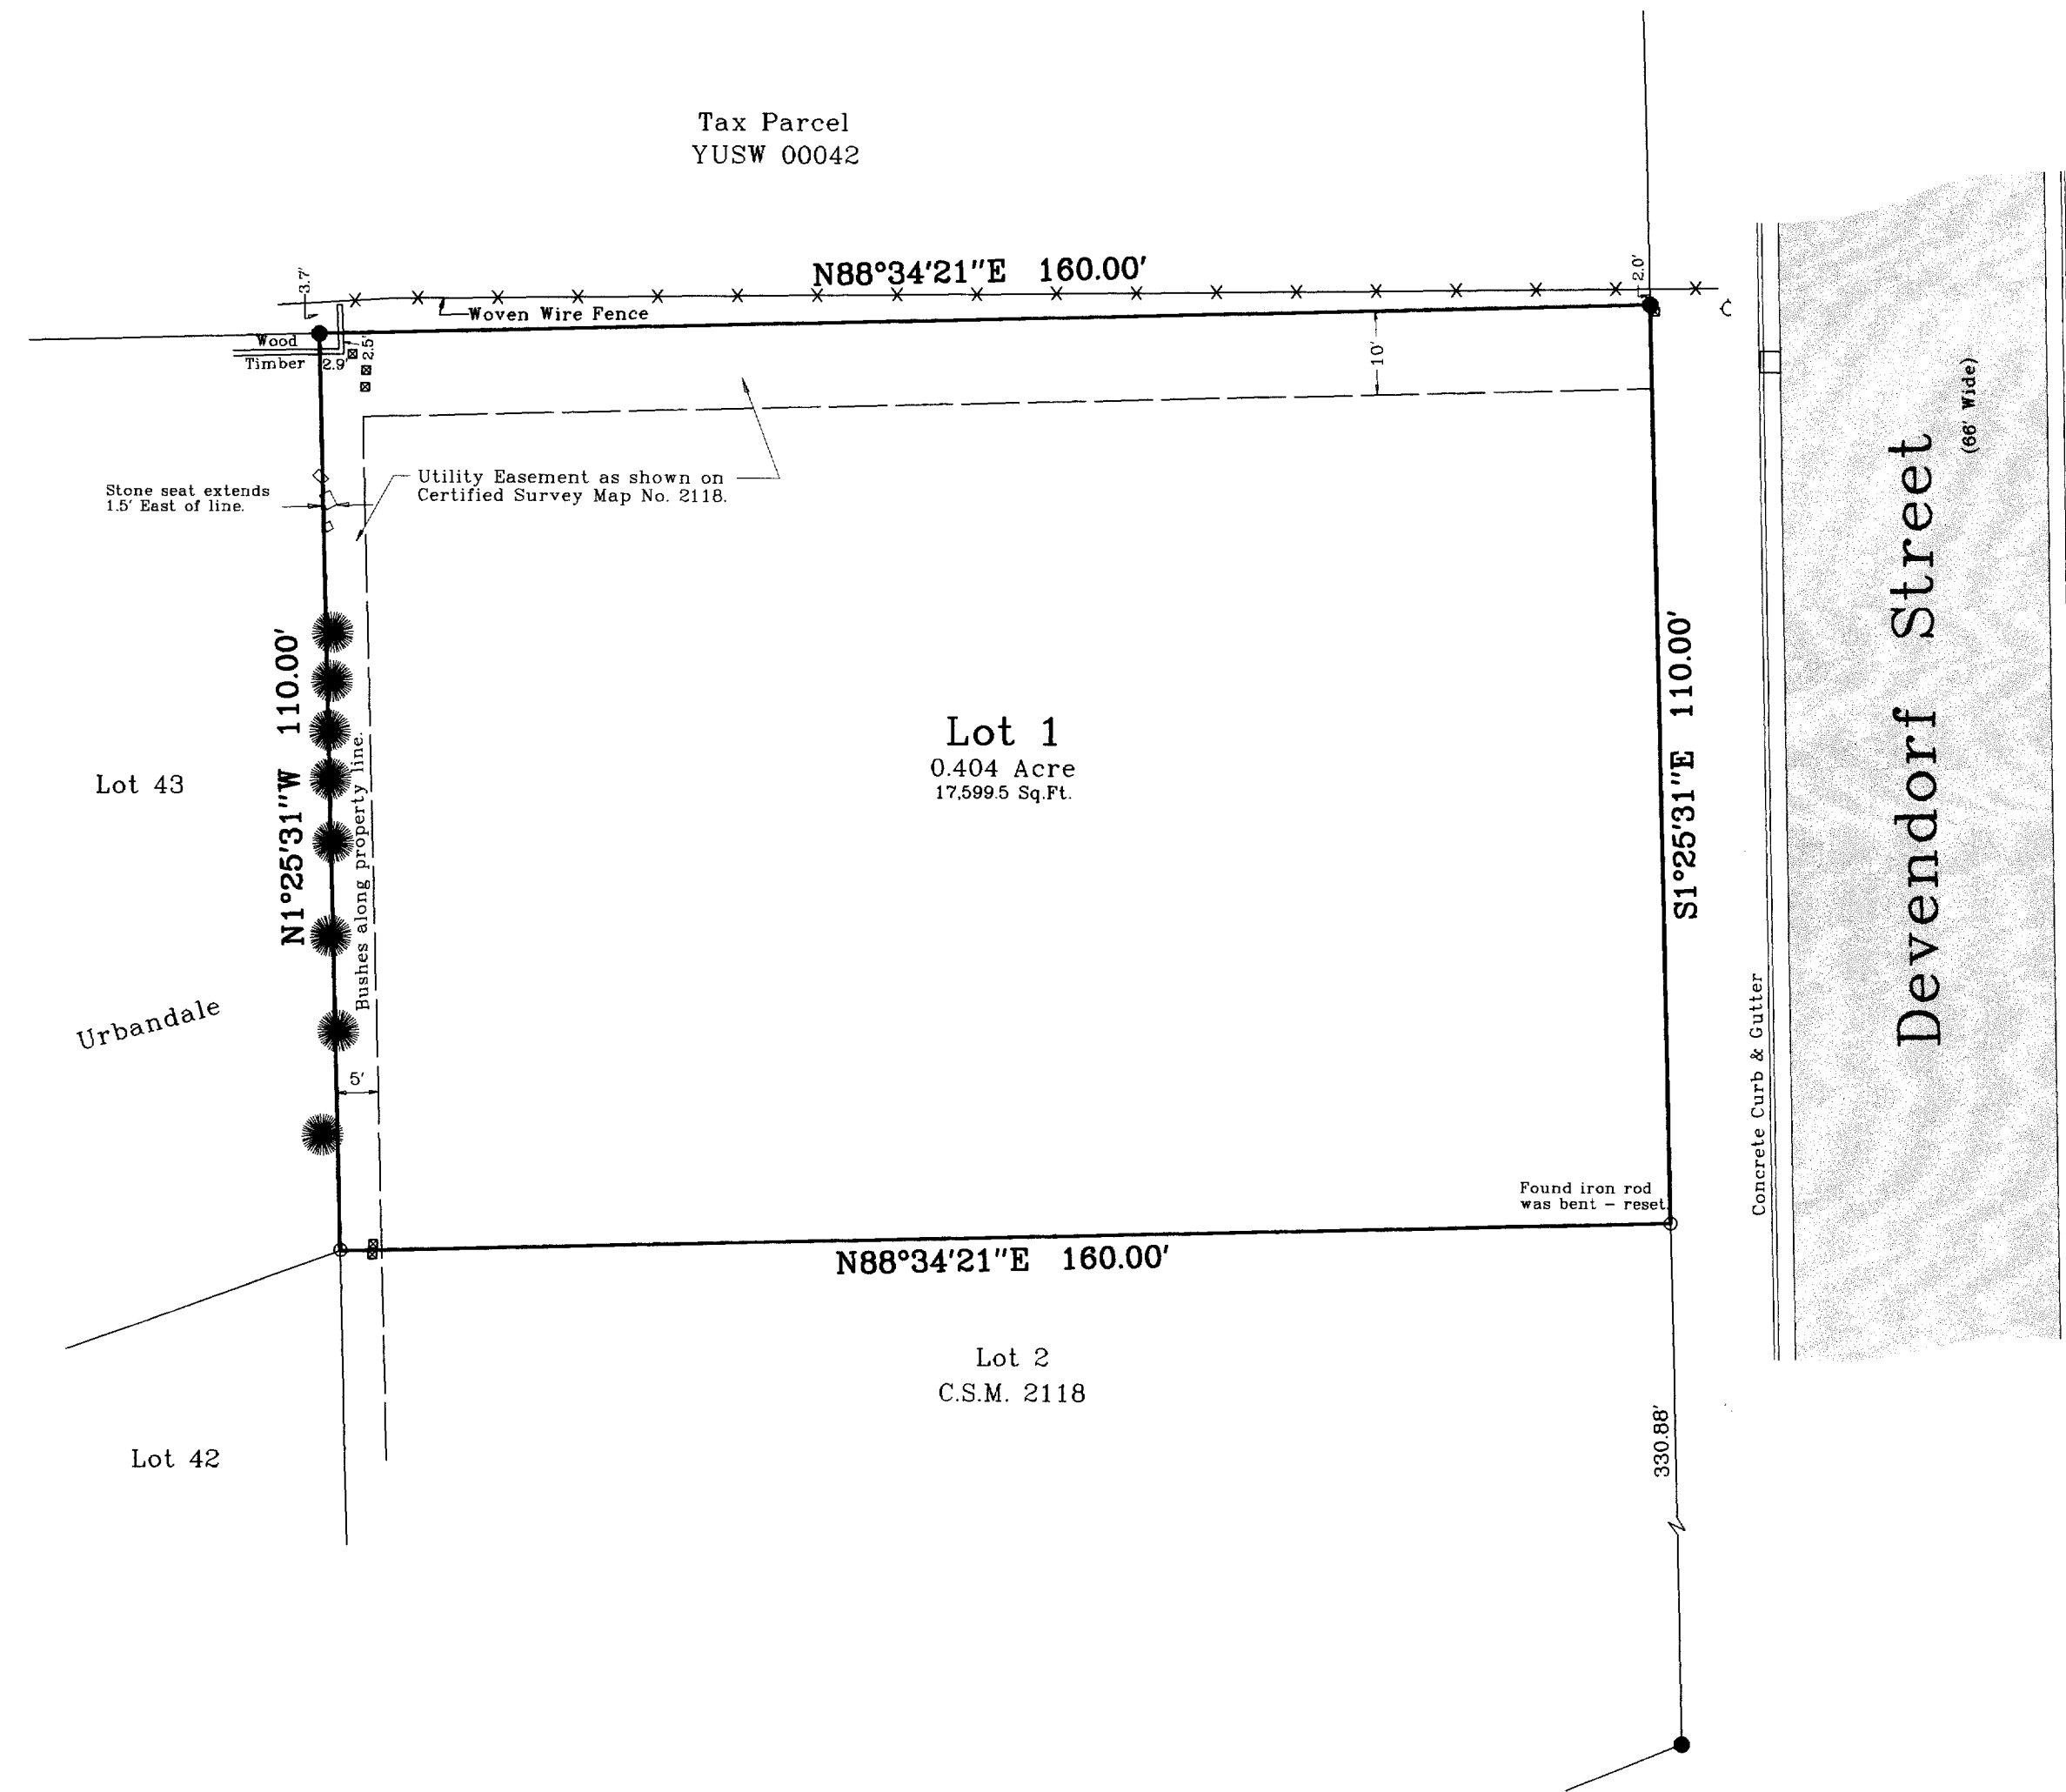

Bearings reference to Certified
Survey Map No. 2118.

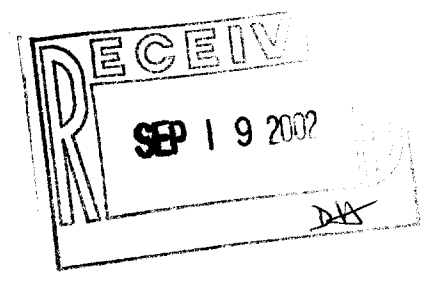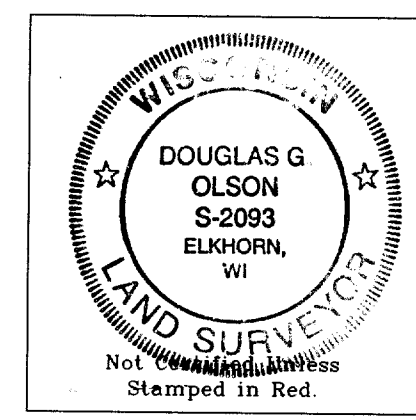

- Notes: 1) This survey plat is not
certified unless signed
and sealed in red ink.
- 2) This survey is subject to Wisconsin lien laws.
This Plat of Survey is the notice of intent
to file lien. Lien waiver required.


Copyright © 2002 by Jensen & Olson Land Surveying, LLC.

All rights reserved. No part of this survey plat may be reproduced
or transmitted in any form by any means - graphic, electronic, or
mechanical, including photocopying, tracing, or information storage
and retrieval systems - without permission in writing from Douglas
G. Olson, Jensen & Olson Land Surveying, LLC.

I hereby certify that I have surveyed the above described
property and the map hereon is correct to the best of my professional
knowledge and belief and shows the size and location of the property,
its exterior boundaries, the location and dimensions of all visible
structures thereon, boundary fences, apparent easements and roadways
and visible encroachments, if any.
This survey is made for the exclusive use of the present owners
of property, and also those who purchase, mortgage or guarantee title
thereto, within one year from the date hereof.

Douglas G. Olson
Wisconsin Registered Land Surveyor - 2093

Survey Date: August 20, 2002.
Revisions:

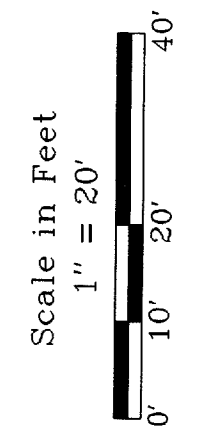

Jensen & Olson Land Surveying, LLC
45 South Wisconsin Street P.O. Box 322
Elkhorn, Wisconsin. 53121
Telephone (262) 723-3434
Facsimile (262) 723-8044

- Legend
- Found Iron Rod, 1-3/16" dia.
 - Found Iron Rod, 3/4" dia.
 - Recorded Information
 - Utility Pedestal
 - Fire Hydrant
 - Catch Basin
 - Bush

Sheet 1 of 1 Sheets
Job Reference Number
2002.148

2002.148

004-1521