


**SURVEYING & SUBDIVIDING
DELAVER, WISCONSIN**



I, George T. Dunham, Surveyor, certify that I have surveyed the property described as follows, Lot 4, Block 2 of Tree Towns Subdivision located in the Northwest $\frac{1}{4}$ of the Northwest $\frac{1}{4}$ of Section 31, T 3 N, R 17 E, City of Elkhorn, Walworth County, Wisconsin,

George T. Dunham
George T. Dunham, Surveyor

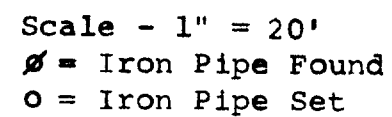