
PREPARED FOR: RENAE DUNBAR C-21 SKANDIA 822 E GENEVA DELAVAN, WI, 53115

PLAT OF SURVEY

I.K. SURVEYING INC. N3705 WILLOWBEND LANE LAKE GENEVA, WI, 53147 262-248-3697

THE EAST 671/2 FEET OF LOT 2, BLOCK 18, ORIGINAL PLAT OF THE CITY OF ELKHORN, WALWORTH COUNTY, WISCONSIN.

JEFFERSON STREET

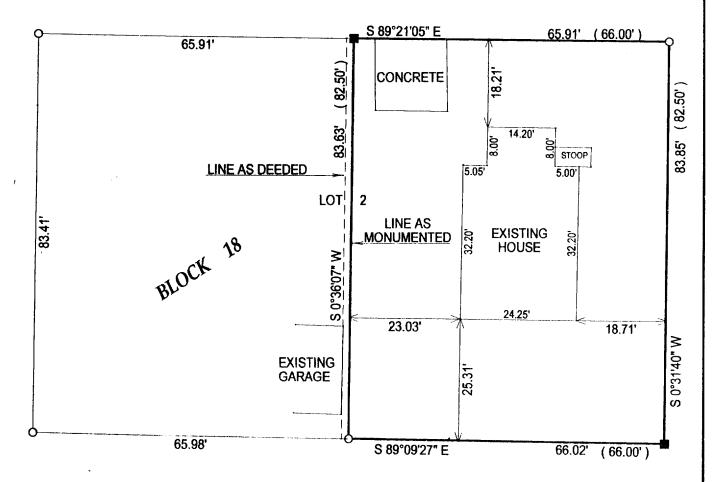



DEC 1 7 2002

IT IS THE BELIEF OF THE SURVEYOR THAT THE DEED IS INCORECT AND THE LOT SHOULD BE 66 FEET WIDE NOT 67.50 FEET WIDE. PER MONUMENTATION

DH

)= recorded as

= set iron bar

= found iron bar

= found iron pipe

= set iron pipe

COMPARE LEGAL DESCRIPTION ABOVE AND DRAWING WITH DEED. FOR BUILDING RESTRICTIONS AND EASEMENTS NOT SHOWN, REFER TO DEED, ABSTRACT SOURCES AND LOCAL MUNICIPAL CODES. NOTIFY THE SURVEYOR IMMEDIATELY OF ANY DISCREPANCY.

"I hereby certify that I have surveyed the above described property and that the above map is a true representation thereof and shows the size and location of all visible structures, apparent easements and encroachments

This survey is made for the present owners of the property, and those who purchase, mortgage, or guarantee the title thereto, within one year from

the date hereof.

JOB# 02-496

SCALE: 1"=20'

TAX KEY # YOP00126

DATED THIS THE 23rd DAY OF 2002.

NOTE: BEARINGS REFRENCED FROM MAGNETIC NORTH.

JEFFREY L KIMPS 5 - 2438 Wisconsin Registered Land Surveyor (original if signed in red)