


PLAT OF SURVEY

LOT 13, JACKSON CREEK EAST SUBDIVISION, located in the Southwest ¼ and Southeast ¼'s of the Southwest ¼ of Section 7, Town 2 North, Range 17 East, City of Elkhorn, Walworth County, Wisconsin.


Surveyed for: Bielinski Brothers Builders/ Kevin and Angelique Erdman

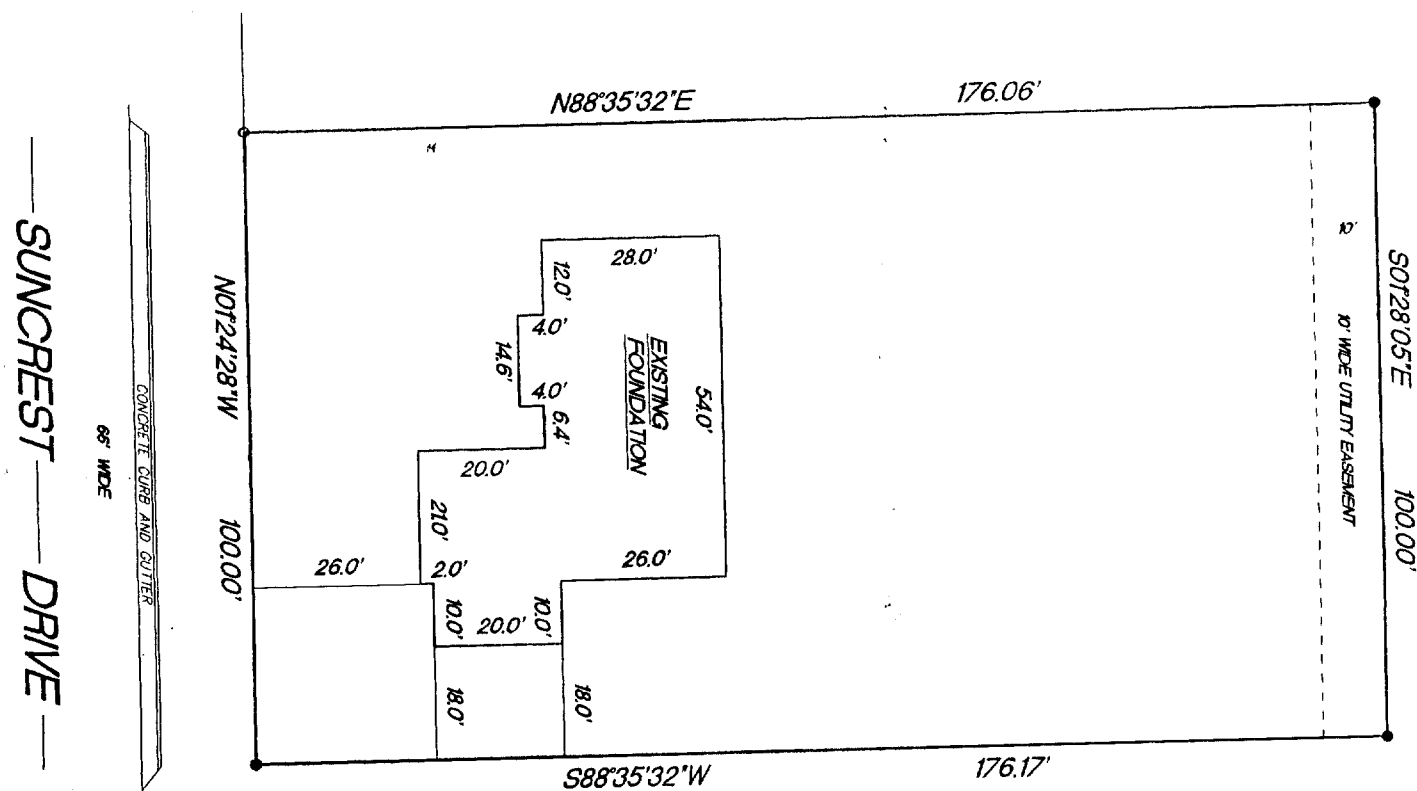

"I hereby certify that I have surveyed the above described property and that the above map is a true representation thereof and shows the size and location of the property, its exterior boundaries, the location of all visible structures and dimension of all principal buildings thereon, boundary fences, apparent easements, roadways and encroachments if any."

"This survey is made for the use of the present owners of the property, and also those who purchase, mortgage or guarantee the title thereto within one year from date hereof."

KETTLE MORaine SURVEYING, INC. TERRANCE E. PISAREK
W356 S9050 Godfrey Lane
Eagle Wisconsin 53119
P.O. Box 357
(262) 594-3484
Terrance E. Pisarek R.L.S.

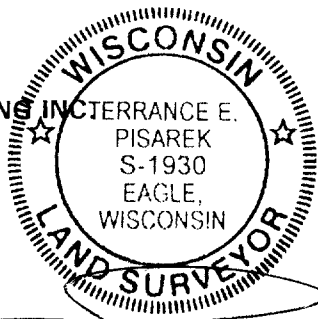

THIS IS NOT AN ORIGINAL SURVEY UNLESS THE SEAL IS RED.

REV. 11/7/02
REV. 10/18/02
9/26/02

DATE

TEP/DW

FIELD WORK BY

TEP

DRAWN BY

02168

JOB NUMBER

YJCE-13

004-1556