


DESCRIPTION: Lots #5, #8, #9, #11, #12, 13, #14, #15, #16, #17, of Block No. 1 of the Rockwell Brothers Addition to the City of Elkhorn, Walworth County, Wisconsin; also a piece bounded and described as follows: Commencing at the NW corner of Lot #15 of said Block, thence west 19.08 feet to an iron stake, thence south 198.00 feet to an iron stake, thence east 19.05 feet to a point, said point being the SW corner of Lot #17 of said block, thence North 198.00 feet to the place of beginning.

CERTIFICATE: I, James F. Biagi surveyor do hereby certify that I have surveyed the property hereon described, and that the location of all the improvements are as shown on the drawing above.

SIGNED AND SEALED THIS 21ST DAY OF APRIL 1960.

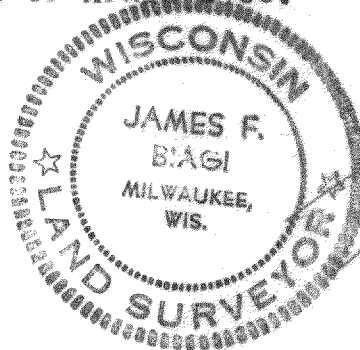

James F. Biagi
James F. Biagi RLS 272

new Cert. Survey 756 ~~1-6-50-46~~

4-15 AB-12-28

60-22