




PLAT OF SURVEY

LOT 1 OF CERTIFIED SURVEY MAP NO. 2118, recorded in Vol. 10 of Certified Survey Maps of Walworth County on Page 125 and located in the Northwest ¼ of Section 1, Town 2 North, Range 16 East, City of Elkhorn, Walworth County, Wisconsin.

Surveyed for: Bielinski Brothers Builders/ Wayne and Stacey Butke

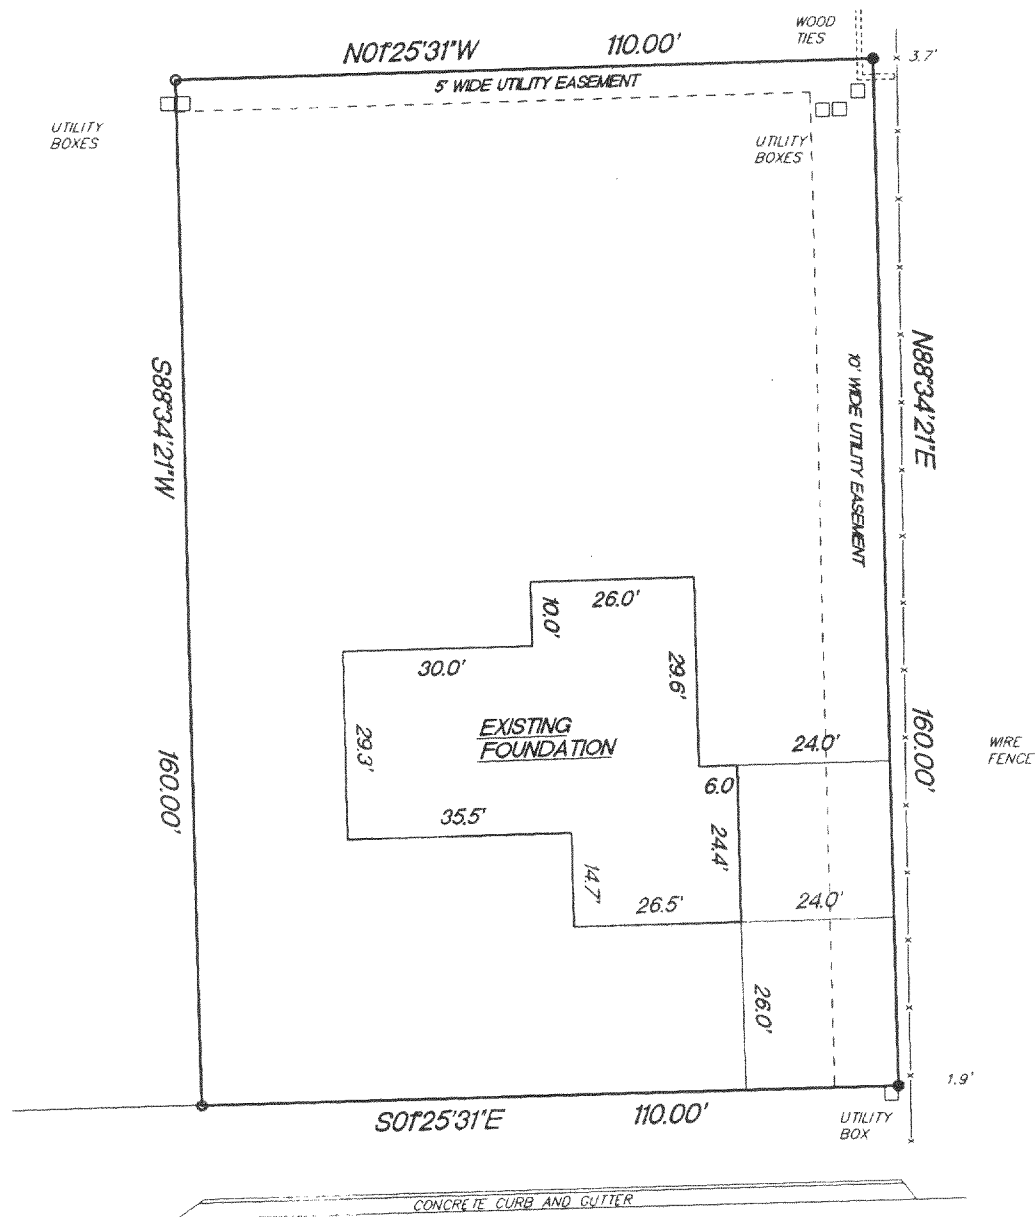

— DEVENDORF — STREET —

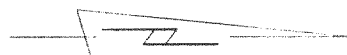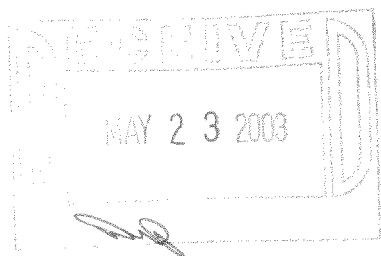

SCALE 1"=30'

- FOUND 1 3/16" IRON ROD
- FOUND 3/4" IRON ROD

"I hereby certify that I have surveyed the above described property and that the above map is a true representation thereof and shows the size and location of the property, its exterior boundaries, the location of all visible structures and dimension of all principal buildings thereon, boundary fences, apparent easements, roadways and encroachments if any."

"This survey is made for the use of the present owners of the property, and also those who purchase, mortgage or guarantee the title thereto within one year from date hereof."

KETTLE MORaine SURVEYING INC.


W356 S9050 Godfrey Lane

Eagle Wisconsin 53119

P.O. Box 357

(262) 594-3484

Terrance E. Pisarek R.L.S.

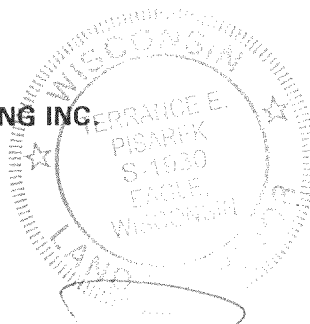

THIS IS NOT AN ORIGINAL SURVEY UNLESS THE SEAL IS RED.

REV. 4/4/03
3/3/03

DATE

TEP/DW

FIELD WORK BY

TEP

DRAWN BY

02220

JOB NUMBER

YA2118-1

004-1594