# Plat of Survey

#### Lot 1 of Block 8 of Edgewood 4th Addition,


a subdivision located in the Northwest 1/4 of Section 36, Town 3 North, Range 16 East, City of Elkhorn, Walworth County, Wisconsin.

Surveyed for:

Misty Gray

406 Westlawn Avenue Elkhorn, Wisconsin. 53121

Tax Parcel YUNW 00058

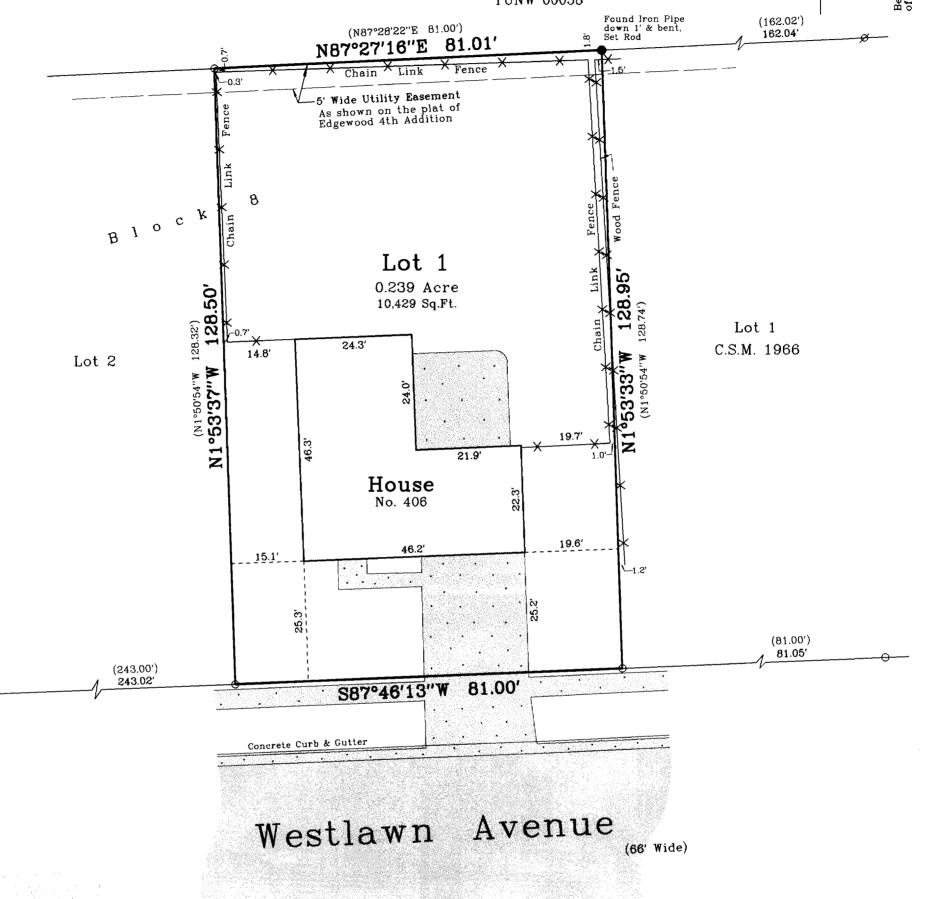

SEP | 8 2008 YW

Copyright c 2003 by Jensen & Olson Land Surveying, LLC.

All rights reserved. No part of this survey plat may be reproduced or transmitted in any form by any means - graphic, electronic, or mechanical, including photocopying, tracing, or information storage and retrieval systems - without permission in writing from Douglas G. Olson, Jensen & Olson Land Surveying, LLC.

certify that I have surveyed the above described I hereby certify that I have surveyed the above described property and the map hereon is correct to the best of my professional knowledge and belief and shows the size and location of the property, its exterior boundaries, the location and dimensions of all visible structures thereon, boundary tences, apparent easements and roadways and visible encroachments, if the exclusive use of the present owners of property, and also those who purchase, mortgage or guarantee title thereto, within one year from the date hereof.

DOUGLAS G OLSON S-2093 EUKTORN, Not Certified Unless Stamped in Red.

Notes:

1) This survey plat is not certified unless signed and sealed in red ink.

2) This survey is subject to Wisconsin lien laws. This Plat of Survey is the notice of intent to file lien. Lien waiver required.

## Legend

Ø Found Iron Pipe ○ Found Iron Rod Set Iron Rod, 3/4" dia.

() Recorded Information

Asphalt Surface ..... Concrete Surface VYEA4-6

### Jensen & Olson Land Surveying, LLC

45 South Wisconsin Street P.O. Box 322 Elkhorn, Wisconsin. 53121 Telephone: (262) 723-3434

Sheet 1 of 1 Sheets.

Dougles G. Olson Wisconsin Registered Land Surveyor - 2093

Revisions:

Survey date: August 12, 2003.

Job Reference Number:

Facsimile: (262) 723-8044

Scale: 1'' = 20'

004-1642 2003.120