


#123-71


VAN BUREN STREET

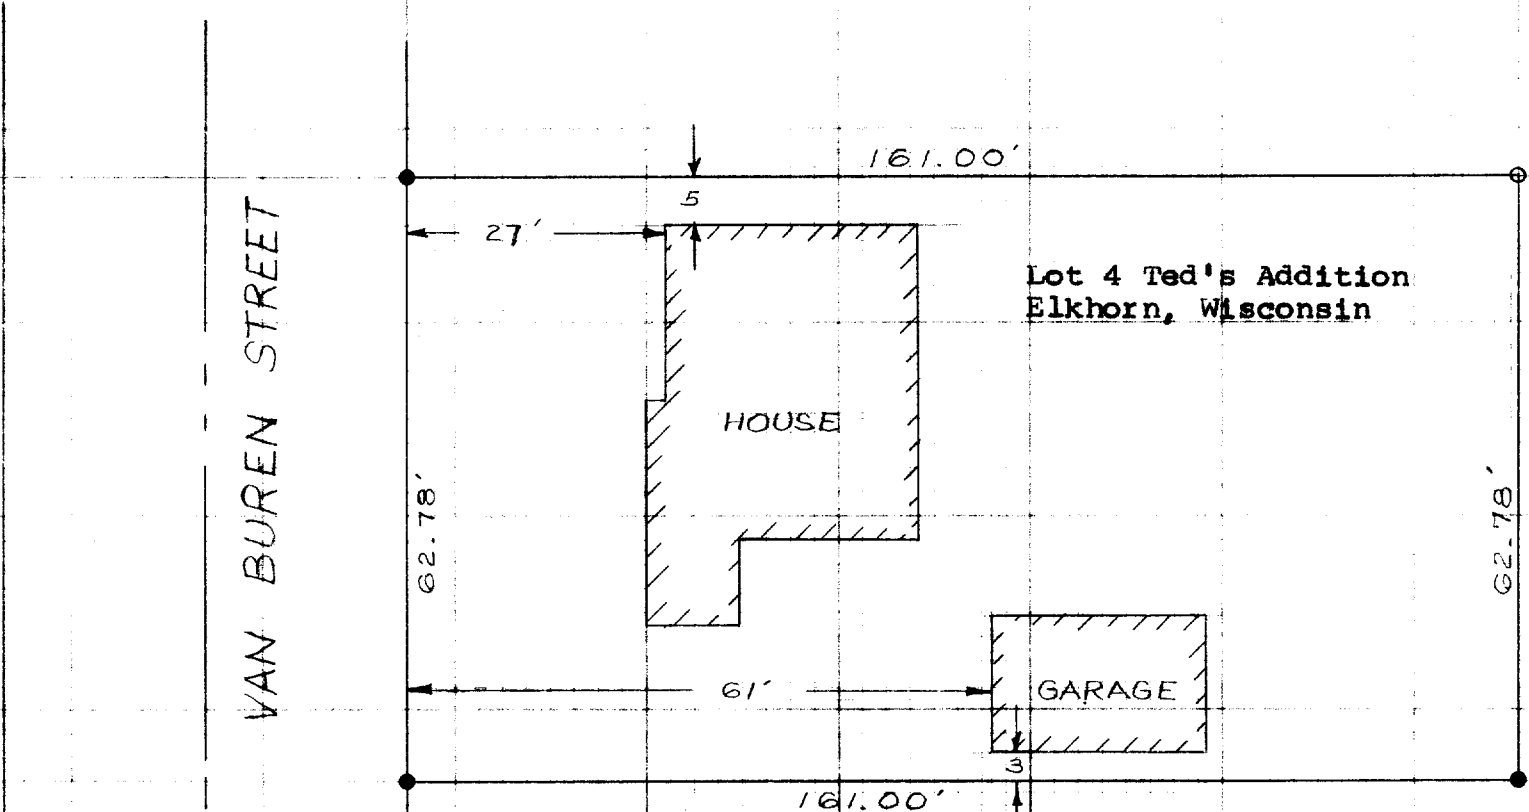

Lot 4 Ted's Addition
Elkhorn, Wisconsin

HOUSE

GARAGE

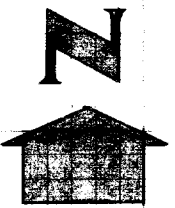

- Iron Pipe Found
 - Iron Pipe Set
- Scale 1"=20'

DESCRIPTION:

Lot 4, of Ted's Addition to the City of Elkhorn,
Walworth County, Wisconsin.


CERTIFICATE:

I, James F. Biagi, surveyor, do hereby certify
that I have surveyed the lands hereon described,
and that all improvements are as hereon shown.

DATE:

May 26, 1971

James F. Biagi
James F. Biagi R.L.S.272

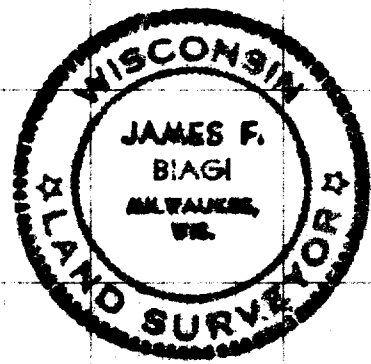

YTA 4

4-16-71B