


7/184-62

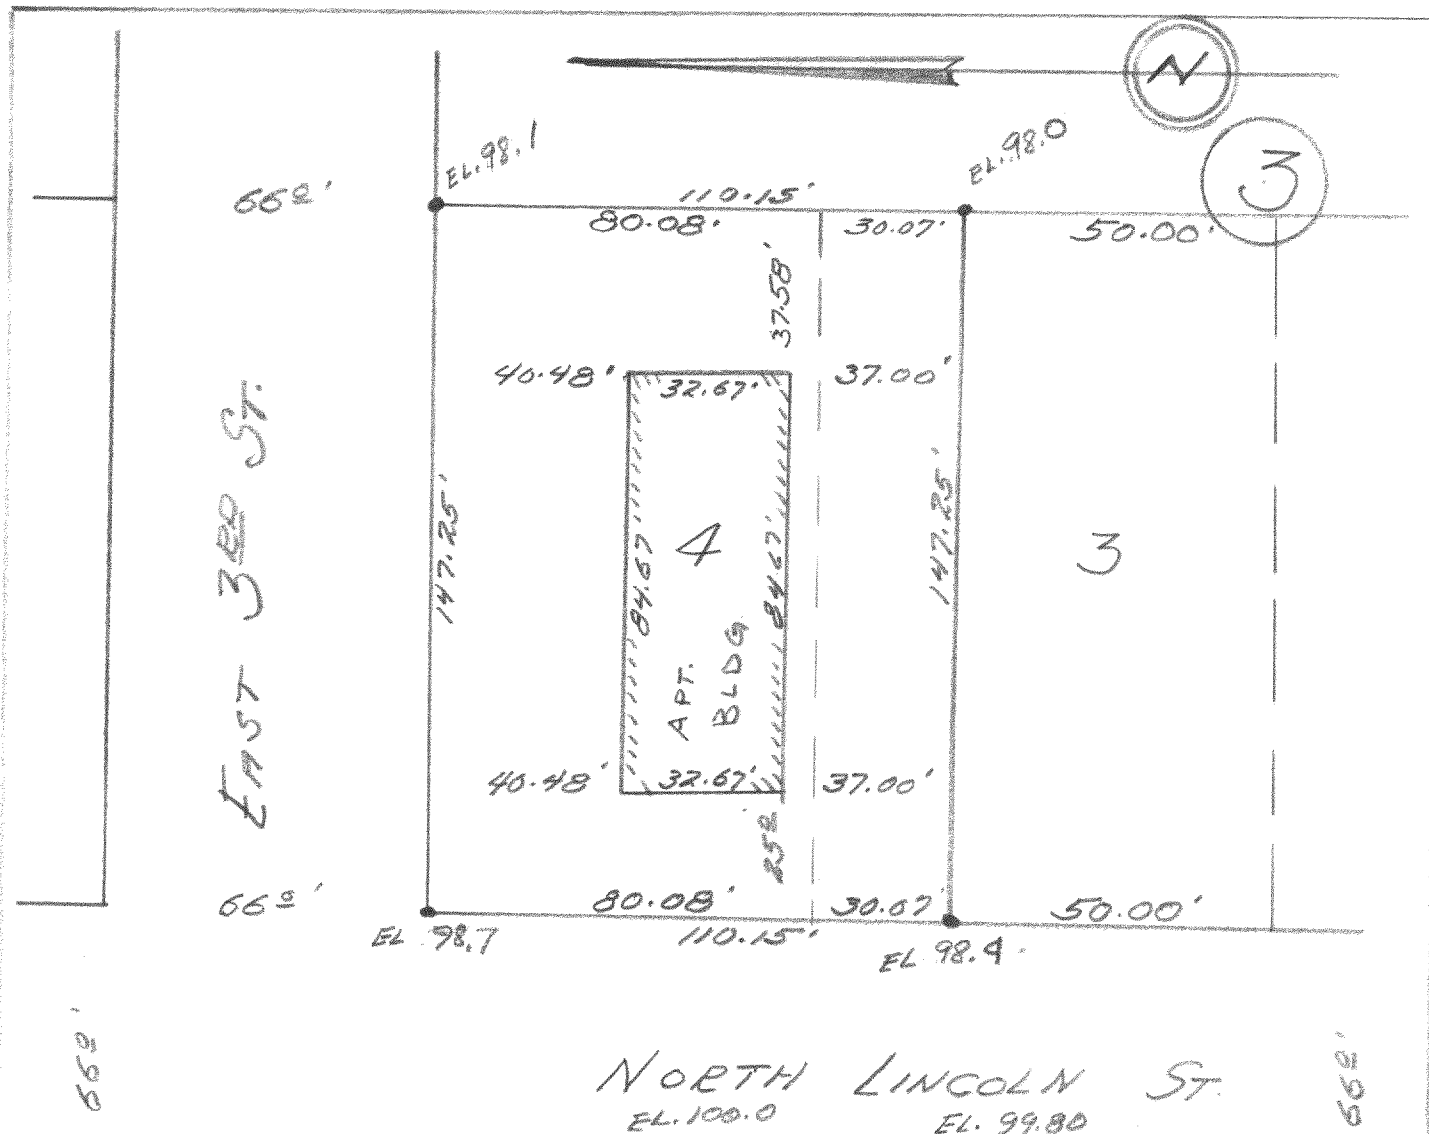

DESCRIPTION:


The North 30.07 feet of Lot 3 Block 3, and all of Lot 4, Block 3, of
~~Town~~ ~~Subdivision~~ of a portion of the City of Elkhorn, Walworth
 County, Wisconsin.

CERTIFICATE:

I, James F. Biagi, surveyor, do hereby certify that I have surveyed the
 property hereon described, and the location of all the improvements
 are as shown on the drawing above.

SIGNED AND SEALED ON THIS THE 20TH DAY OF JULY, 1962.

July 19 1962

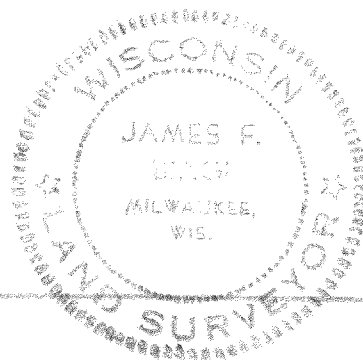

James F. Biagi, RLS 272
 Elkhorn, Wisconsin.

YTT 521

4-169B