


COURT

ST.

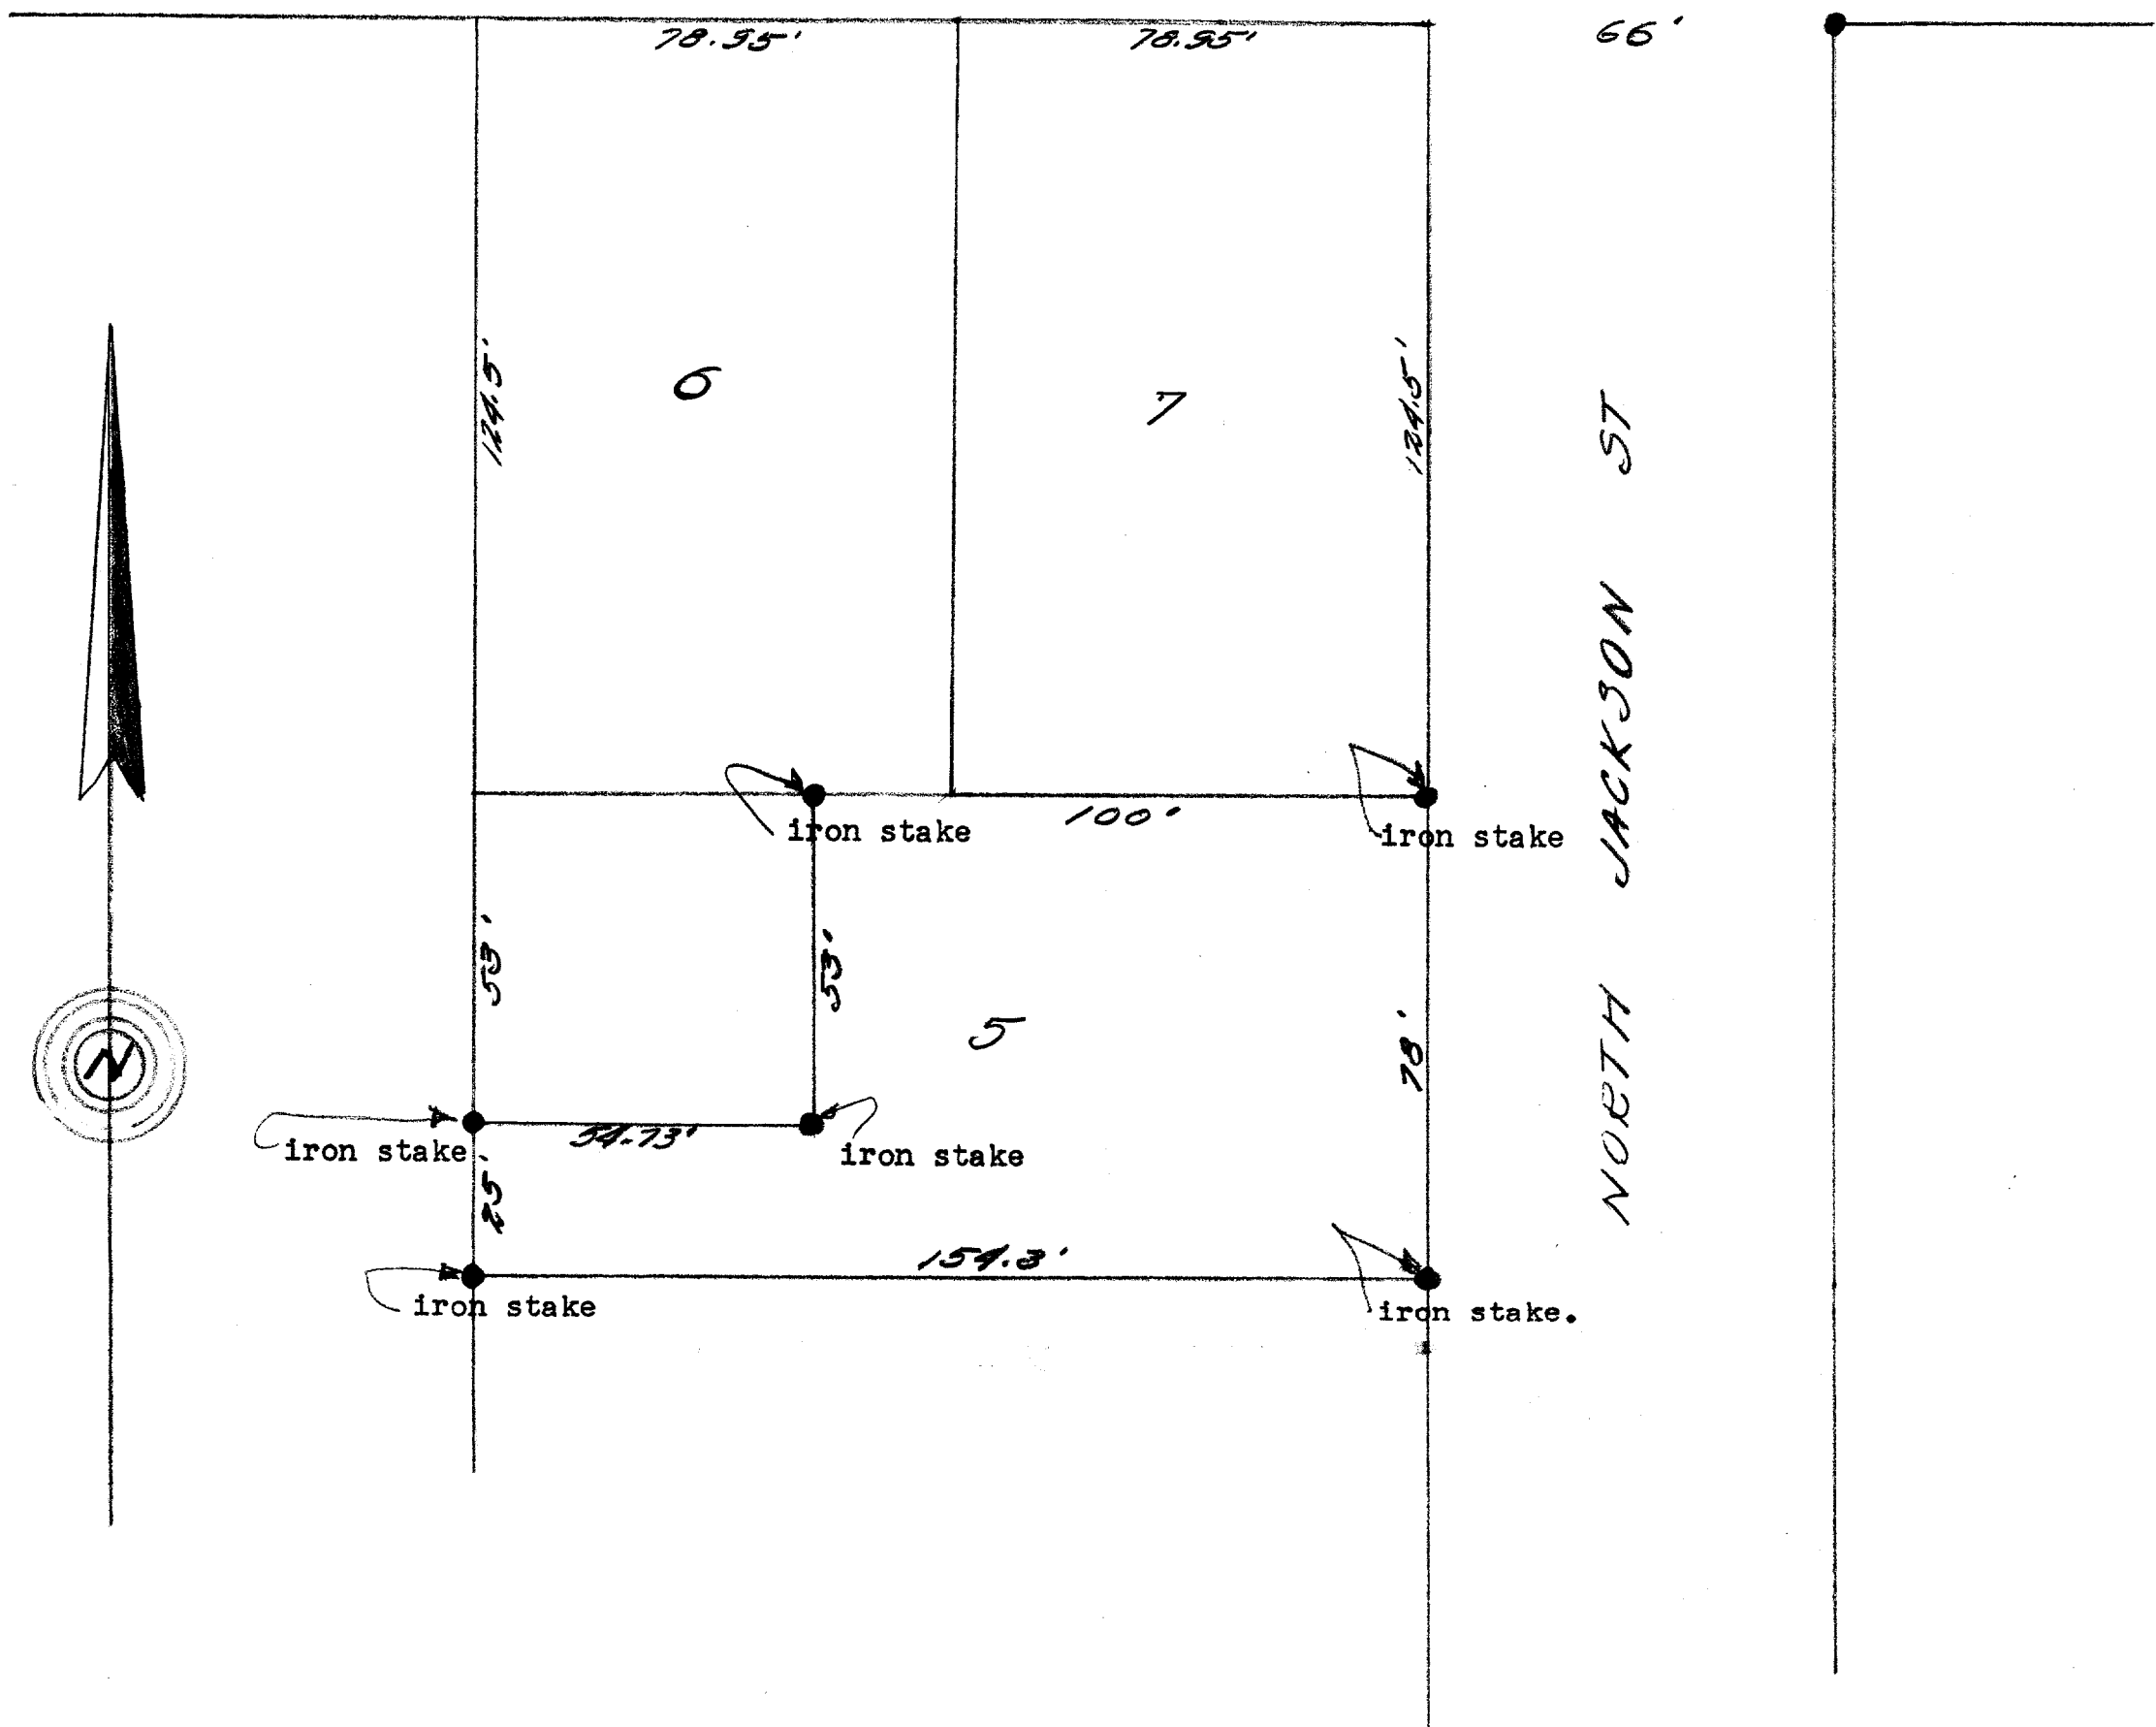

DESCRIPTION: Commencing at the N.E. corner of Lot 5 Block 4, of Arnolds Addition to the Village (now City) of Elkhorn Walworth County, Wisconsin, thence West along the North line of said Lot 5, 100 feet to an iron stake, thence South parallel with the east line of said lot 5, to an iron stake 25 feet North of the south line of said lot 5, thence West parallel with the south line of lot 5, to the west line of lot 5, thence South along the west line of said lot 5, to the southwest corner thereof, thence East along the south line of lot 5, to the east line of said lot, thence north along the east line of said lot to the place of beginning.

CERTIFICATE: I, hereby certify that I have on this the 5th day of August 1946, surveyed the above described property according to the official records on file in the office of the Recorder of Deeds in and for Walworth County Wisconsin, and find that the measurements and bearings of the boundary lines of said property as taken at the site on this day substantially agree with those in the above description, and that no encroachments exist.
SIGNED AND SEALED THIS 6TH DAY OF AUGUST 1946.

Joseph M. Biagi
Joseph M. Biagi.
Professional Engineer
Elkhorn Wisconsin.