


#185-62

EAST 3RD ST.

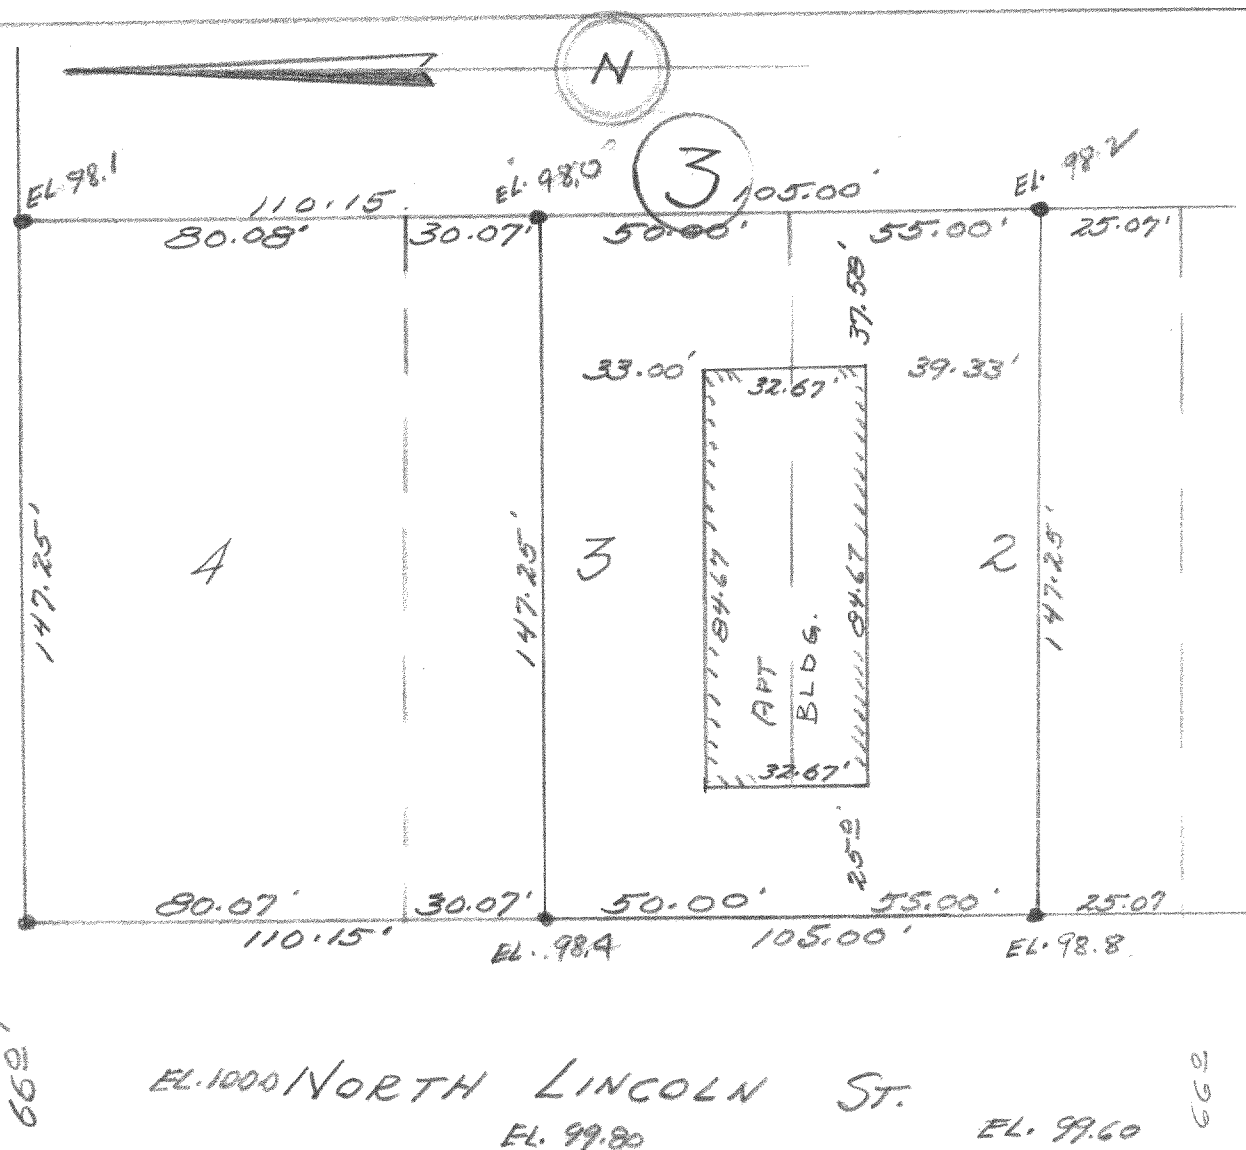


DESCRIPTION:

The South 50.00 feet of Lot 3, Block 3 and the North 55.00 feet of Lot 2, Block 3, of Tree Towns Subdivision of a portion of the City of Elkhorn, Walworth County, Wisconsin.

CERTIFICATE:

I, James F. Biagi, surveyor, do hereby certify that I have surveyed the property hereon described, and that the location of all the improvements are as shown on the drawing above.
SIGNED AND SEALED ON THIS THE 20TH DAY OF JULY, 1962

July 19 1962

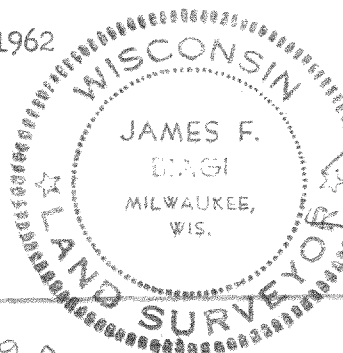

James F. Biagi, RLS 272
Elkhorn, Wisconsin.

TTS-20

4-170B