


59-30


4-173B

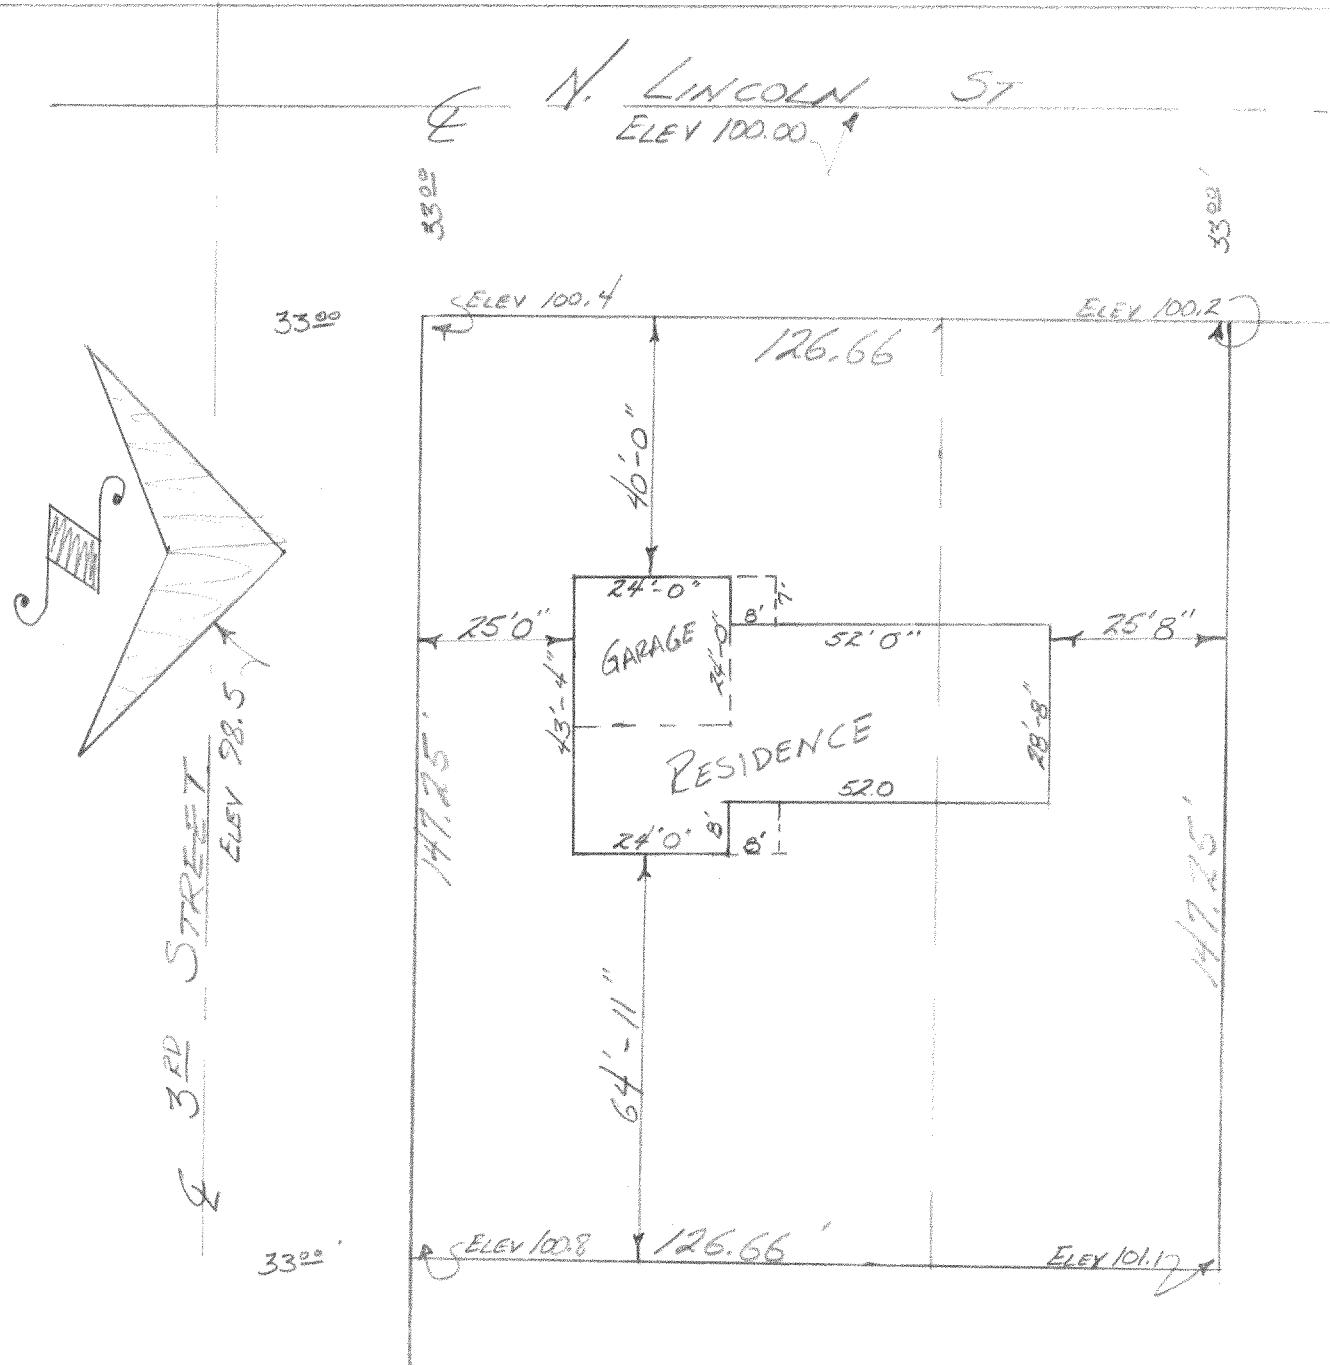

DESCRIPTION: Lot 1 and the South 44.83 feet of lot 2, of Block 1
Tree Towns Subdivision in the City of Elkhorn, Walworth
County, Wisconsin.

CERTIFICATE: I James F Biagi, surveyor, do hereby certify
that I have surveyed the above described property, and that
the location of all the improvements are as shown on the
drawing above

SIGNED AND SWORN TO THIS DAY OF AUGUST 1959

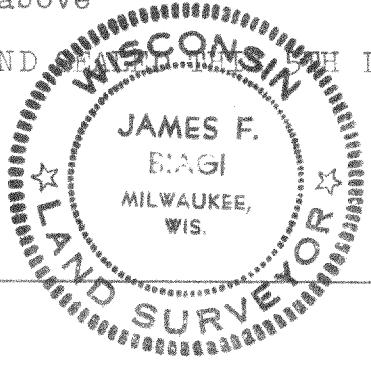

James F. Biagi
Surveyor (212)

YTTS-1

4-173B