



59-42

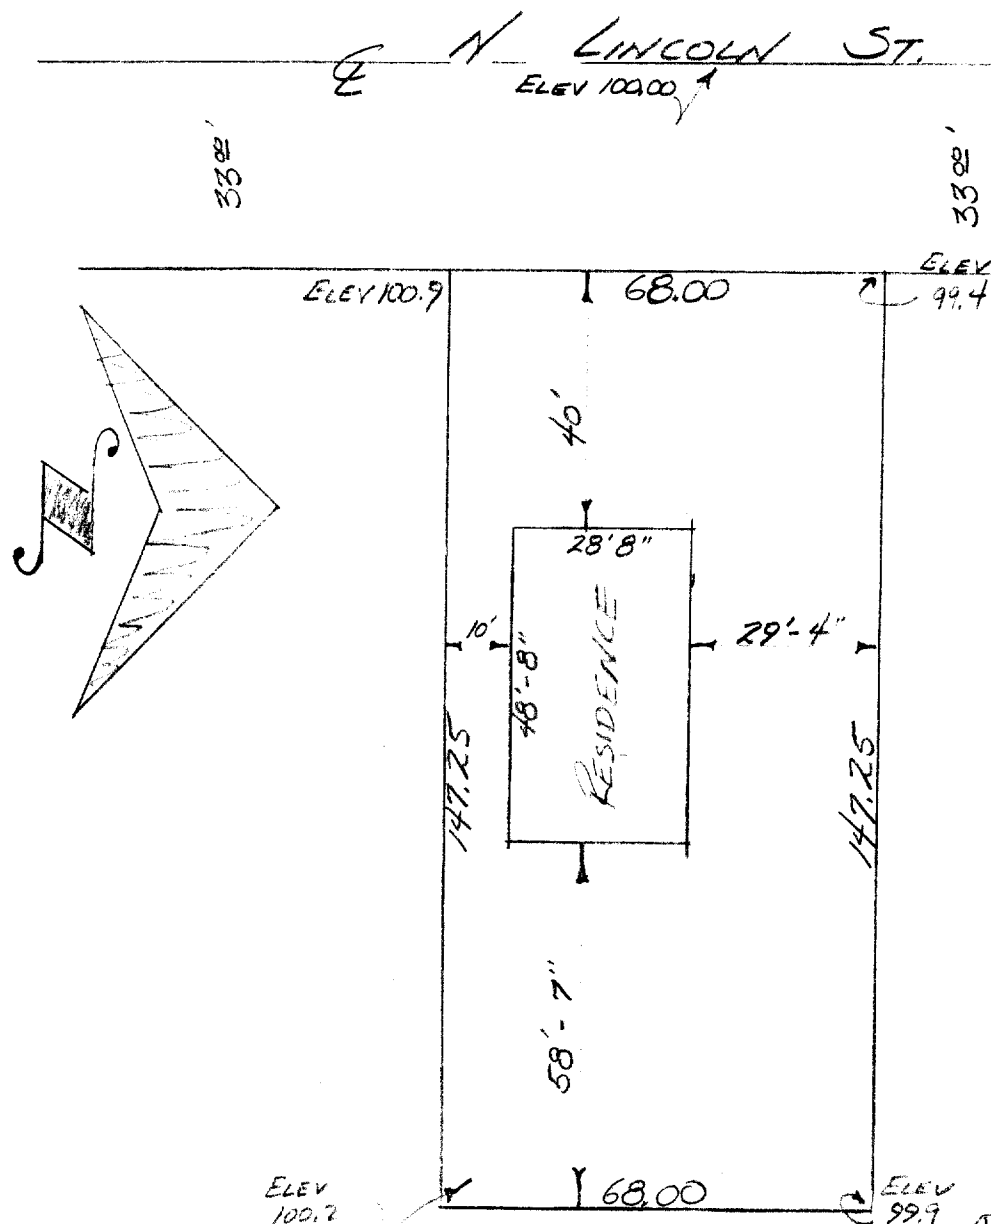

DESCRIPTION: South 68.00' of Lot 5, of Tree Towns Subdivision in the City of Elkhorn, Walworth County, Wisconsin.

CERTIFICATE: I James F. Biagi, Surveyor do hereby certify that I have surveyed the property hereon described, and that the location of all the improvements are as shown on the drawing above.

SIGNED AND SEALED THIS 5TH DAY OF AUGUST 1959

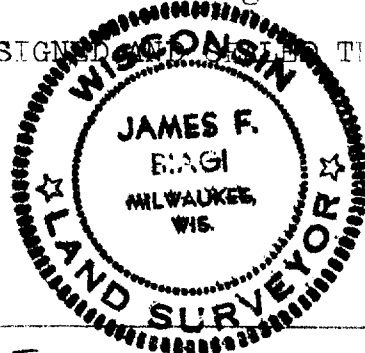

James F. Biagi
Surveyor (272)

TTS-5

4-175