PLAT OF SURVEY

LOCATION:


Grant Street, Elkhorn, Wisconsin

LEGAL DESCRIPTION: Lot 36 in JACKSON CREEK EAST SUBDIVISION , located in the Southwest 1/4 and Southeast 1/4 of the Southwest 1/4 of Section 7, Town 2 North, Range 17 East, City of Elkhorn, Walworth County, Wisconsin.

September 15, 2004

Survey No. 97831



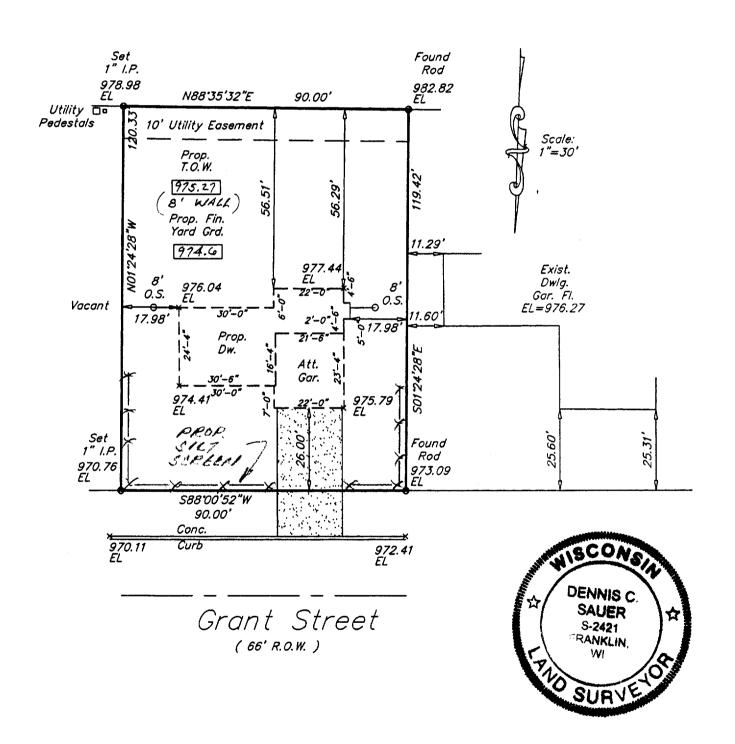

METROPOLITAN SURVEY SERVICE, INC.

REGISTERED LAND SURVEYORS AND CIVIL ENGINEERS 5200 W. LOOMIS ROAD GREENDALE, WI 53129 PH. (414) 529-5380 FAX (414) 529-9787 email address survey@bizwi.rr.com

THIS SURVEY IS MADE FOR THE EXCLUSIVE USE OF THE PRESENT OWNERS OF THE PROPERTY, AND ALSO THOSE WHO PURCHASE, MORTGAGE, OR GUARANTEE THE TITLE THERETO WITHIN ONE (1) YEAR FROM THE DATE HEREOF.

I HEREBY CERTIFY THAT I HAVE SURVEYED THE ABOVE DESCRIBED PROPERTY AND THAT THE ABOVE MAP IS A TRUE REPRESENTATION THEREOF AND SHOWS THE SIZE AND LOCATION OF THE PROPERTY. ITS EXTERIOR BOUNDARIES, THE LOCATION OF ALL VISIBLE STRUCTURES AND DIMENSIONS OF ALL PRINCIPAL BUILDINGS THEREON, BOUNDARY FENCES, APPARENT EASEMENTS AND ROADWAYS AND VISIBLE ENCROACHMENT, IF ANY.

SIGNED

Dennis C. Sauer Registered Land Surveyor S-2421

any

Proposed finished yard. 1st floor or top of foundation grade shown on this drawing is a <u>suggested</u> grade and should be verified by the owner and/or the builder.

004-1778

YJCE 00036