




RECEIVED  
SEP 24 2004

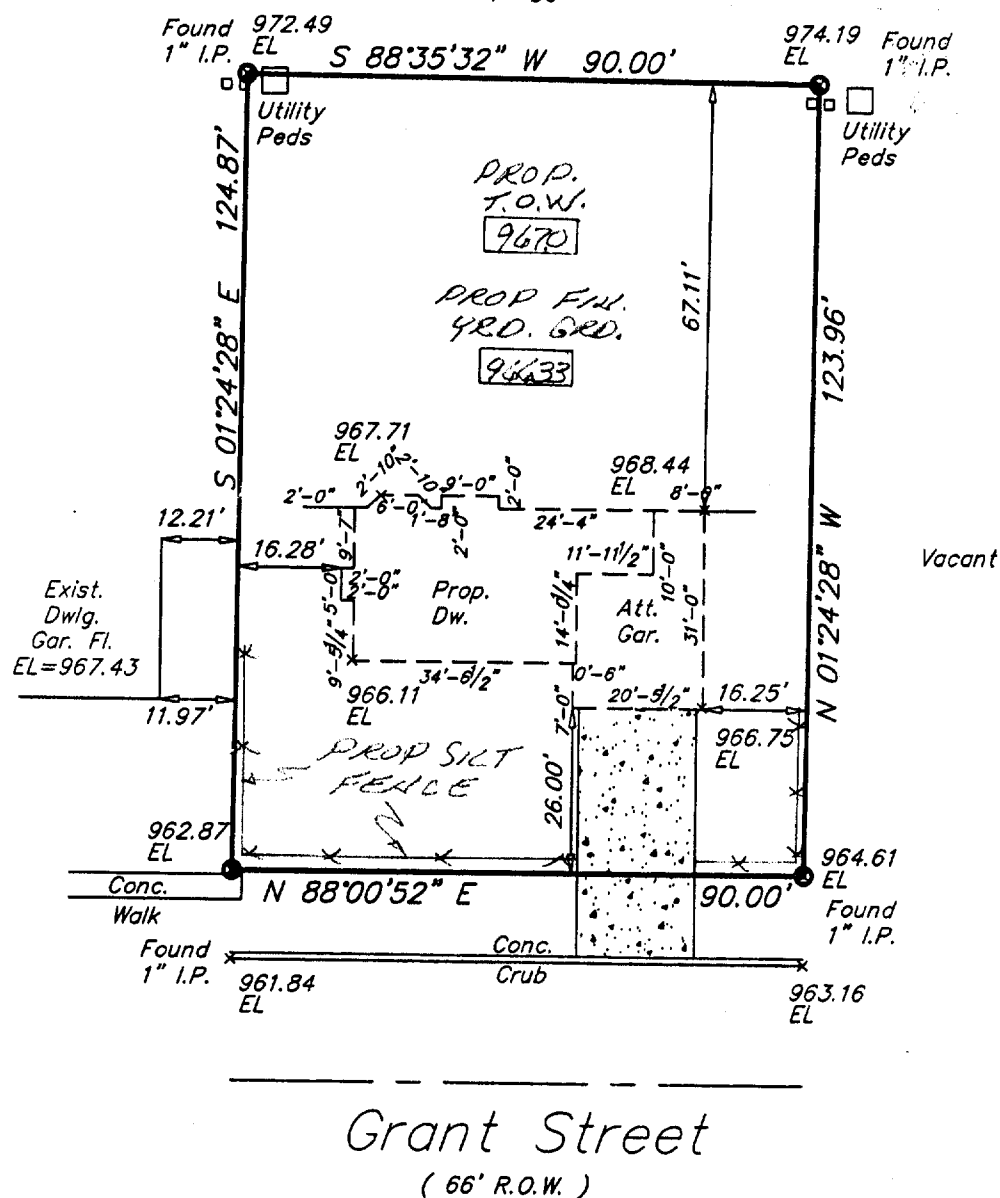

Scale:  
1"=30'

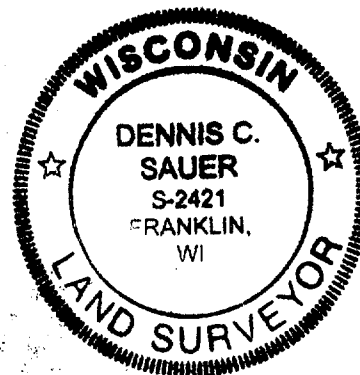

HEREOF.



**Dennis C. Sauer**  
Registered Land Surveyor S-2421

PJCE 00041

004-1782