


61-56

4-179B

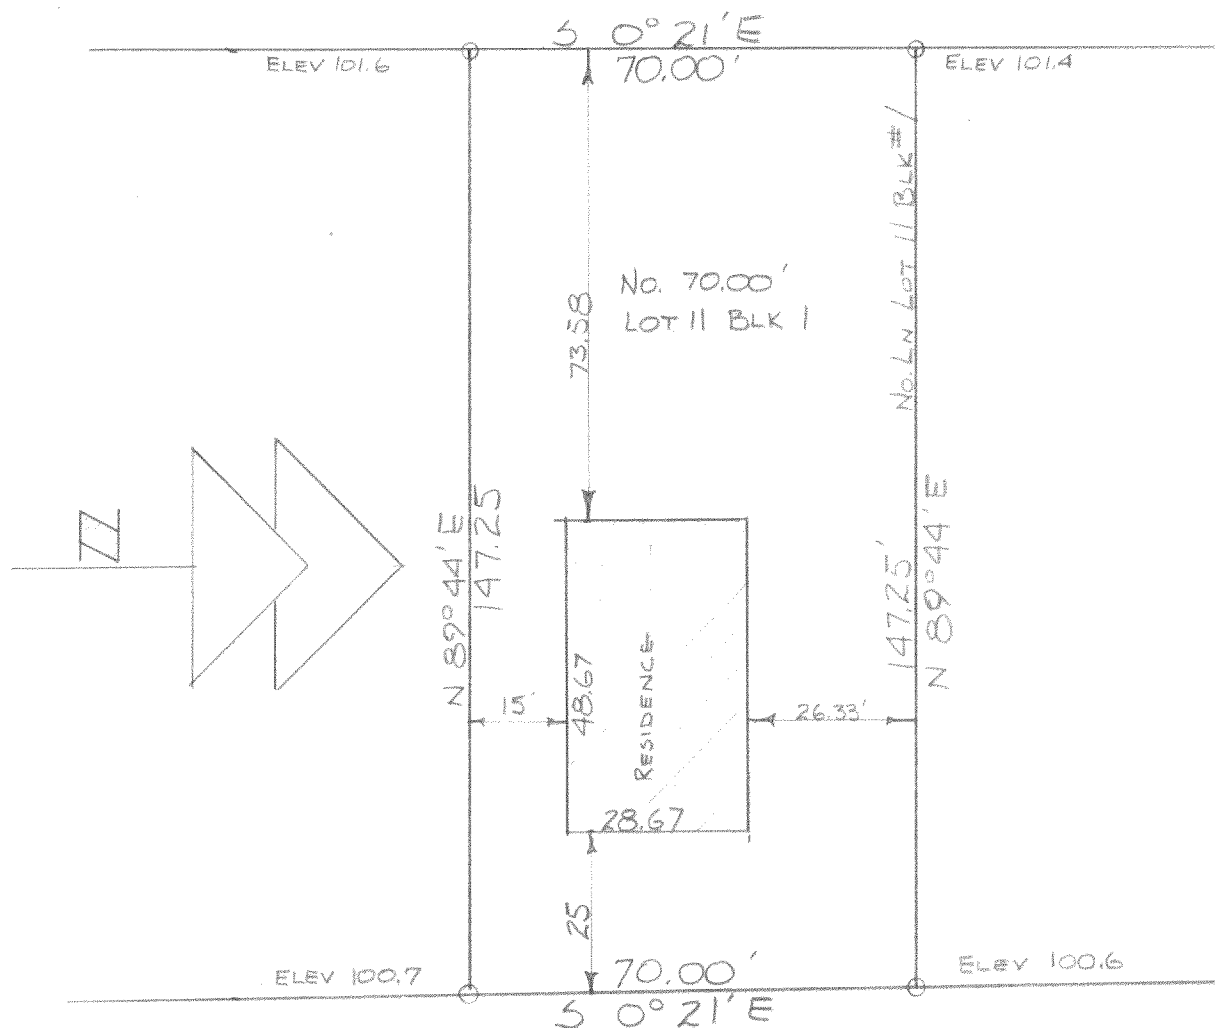


3300

NORTH JACKSON STREET
 ELEV 100.00

DESCRIPTION: The North 70.00 feet of Lot 11 of Block 1 of Tree Towns Subdivision, in the City of Elkhorn, Walworth County, Wisconsin.

CERTIFICATE: I James F. Biagi, surveyor, do hereby certify that I have surveyed the property hereon described, and that the location of all the improvements are as shown on the drawing above.

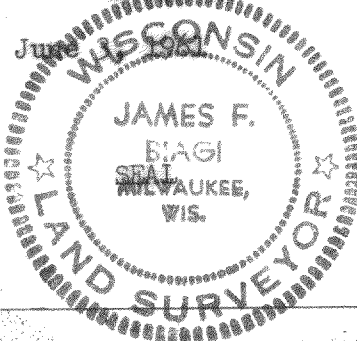

James F. Biagi RLS 272

4-179B

775-11

4-179B