


Mark L. Miritz

**N9330 Knuteson Drive
Whitewater, WI 53190
Phone: (262) 495-3284
FAX : (262) 495-8421
LAND-MARKSURVEYING.COM**

PLAT OF SURVEY



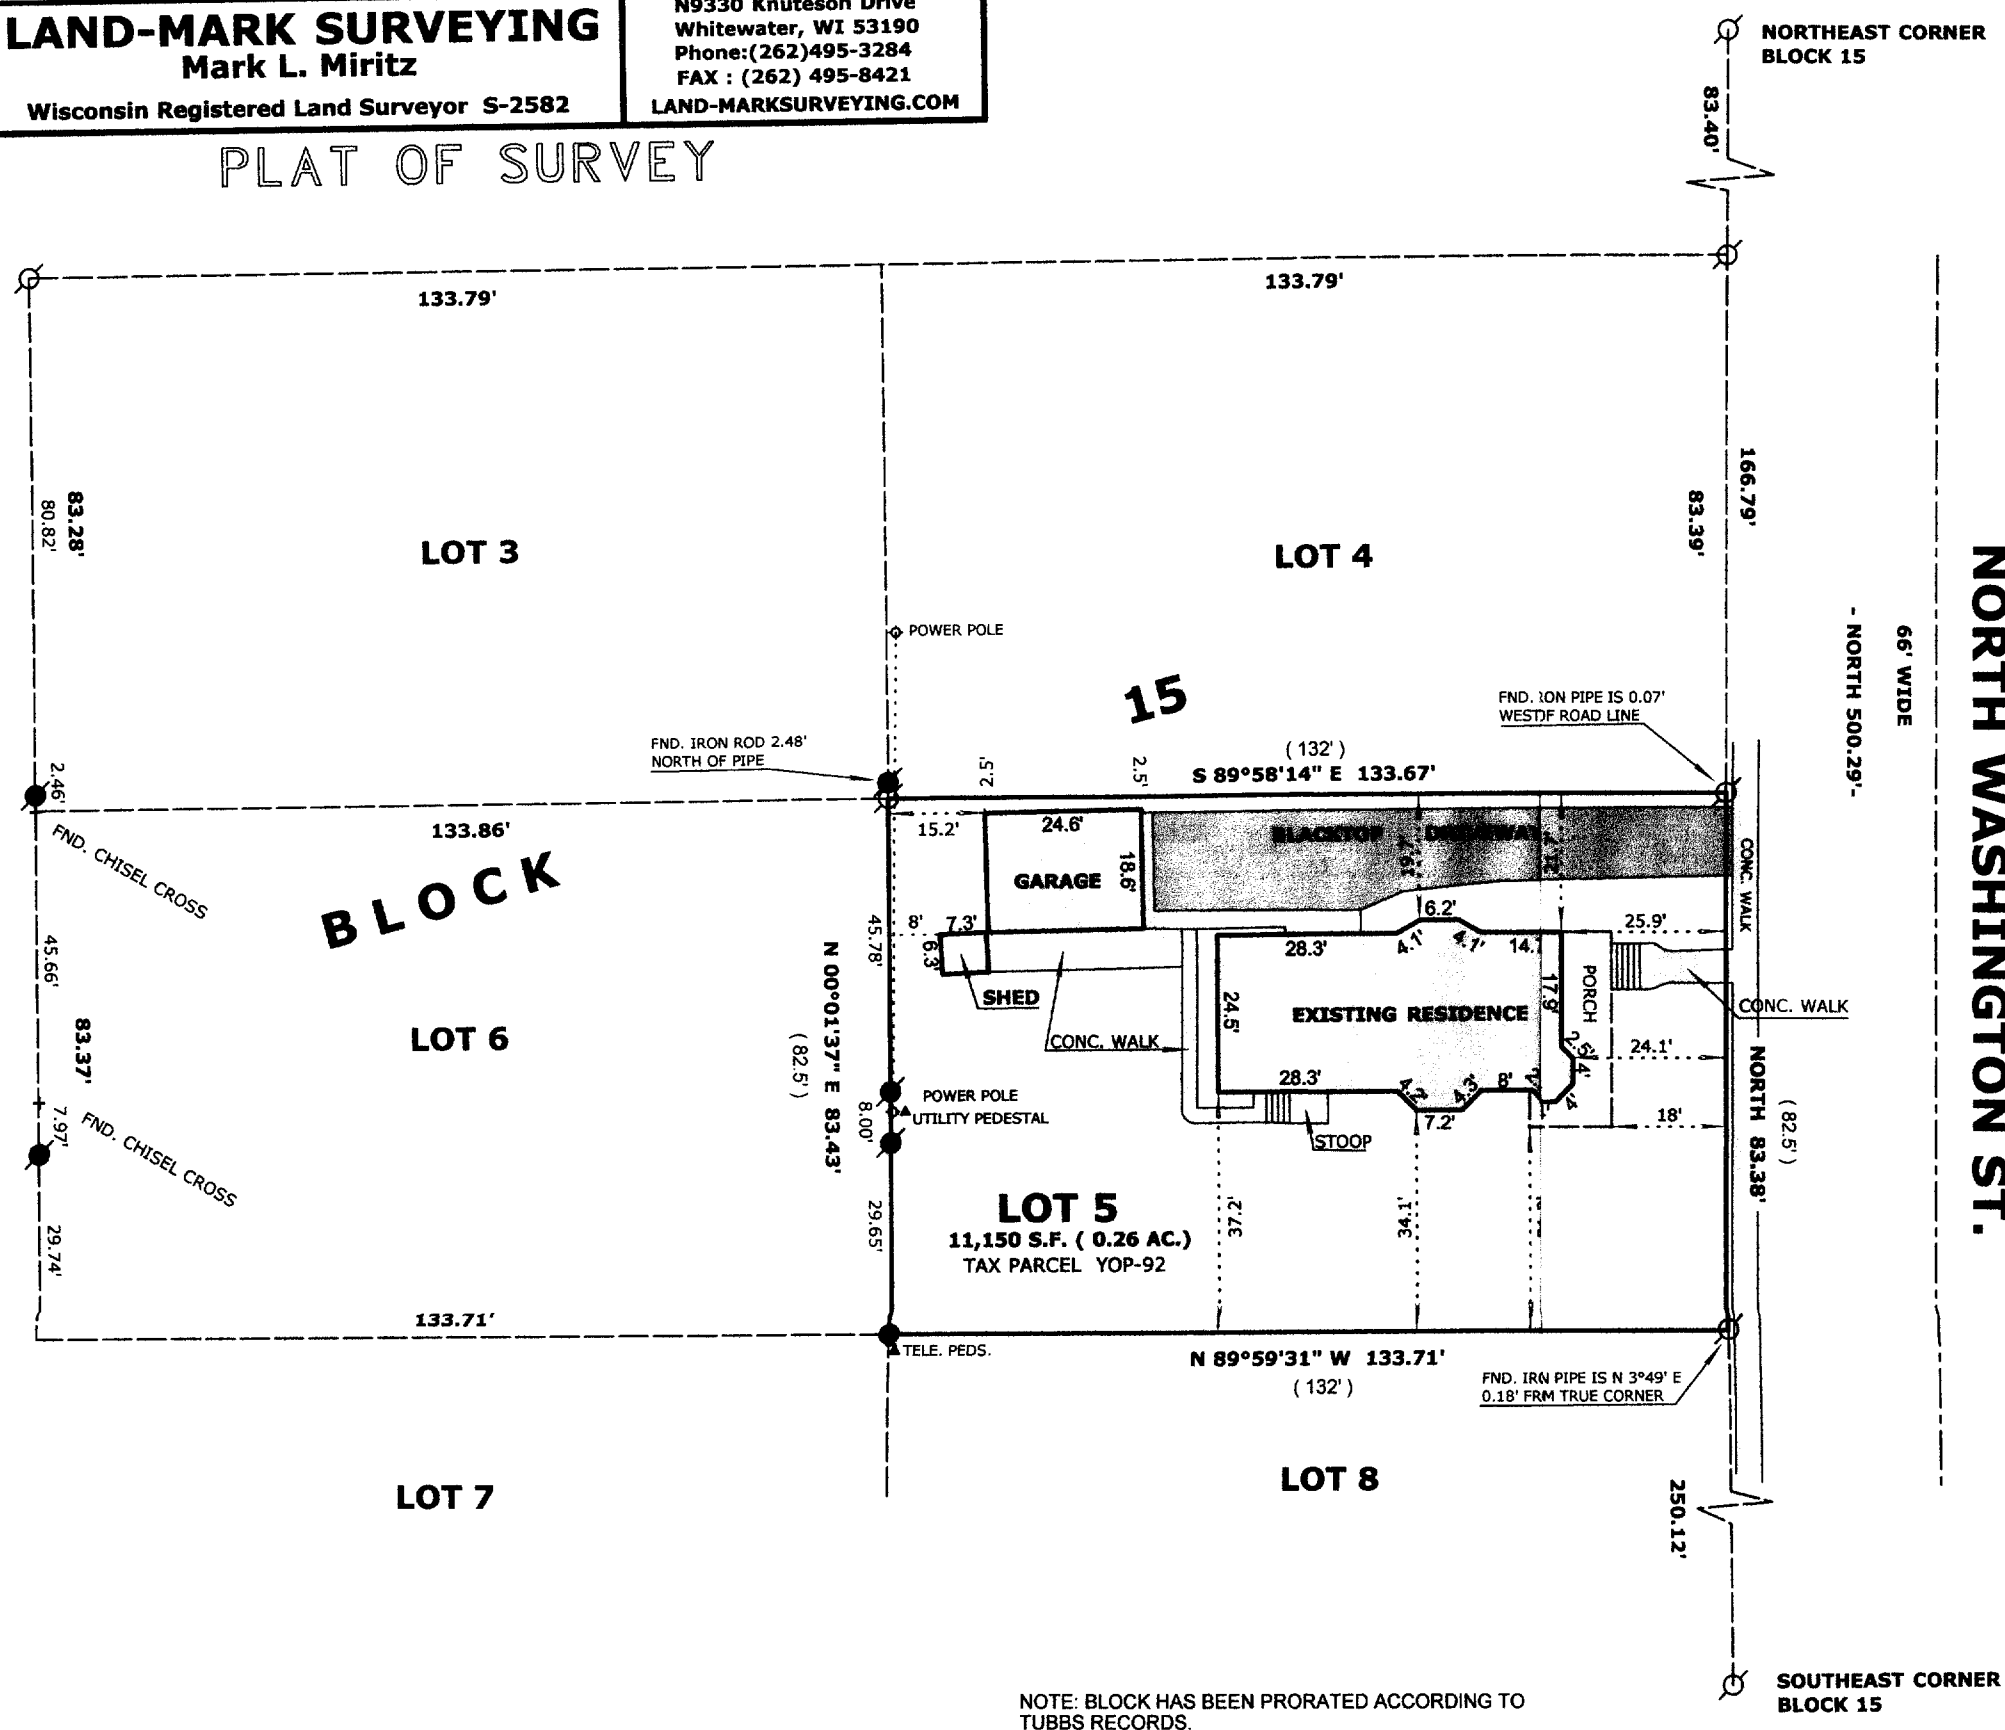





**LOT 5 OF BLOCK 15 OF THE ORIGINAL
PLAT OF THE VILLAGE (NOW CITY) OF
ELKHORN, LOCATED IN THE SE 1/4 OF
SECTION 36, TOWN 3 NORTH, RANGE
16 EAST, CITY OF ELKHORN,
WALWORTH COUNTY, WISCONSIN.**

**OWNERS: LARRY AND KIM STEEN
116 N. WASHINGTON ST.
ELKHORN, WI. 53121**



LEGEND

- | | |
|---|--|
|  | FOUND IRON PIPE |
|  | FOUND IRON ROD |
|  | FOUND COUNTY MONUMENT |
|  | FOUND CONCRETE MONUMENT |
| + | CHISEL CUT IN CONCRETE |
|  | SET IRON ROD, 24" LONG, WEIGHING
1.5 LBS./LINEAL FT., 3/4" DIA. |
| (x x) | RECORDED AS DIMENSION |
|  | EXISTING FENCE |

SCALE: 1" = 30 FEET

"I hereby certify that the above described property has been surveyed by me or under my direction and that the above map is a true representation thereof and shows the size and location of the property, its exterior boundaries, the location of all visible structures and dimensions of all principal buildings thereon, boundary fences, apparent easements, roadways and visible encroachments, if any."

"This survey is made for the use of the present owners of the property, and also those who purchase, mortgage, or guarantee the title thereto within one year from date hereof."

MARK L. MIRITZ
WISCONSIN REGISTERED
LAND SURVEYOR S-2582

DATE: MAR. 30, 2005 JOB NO. 05.314

YOP 00092

004-1835