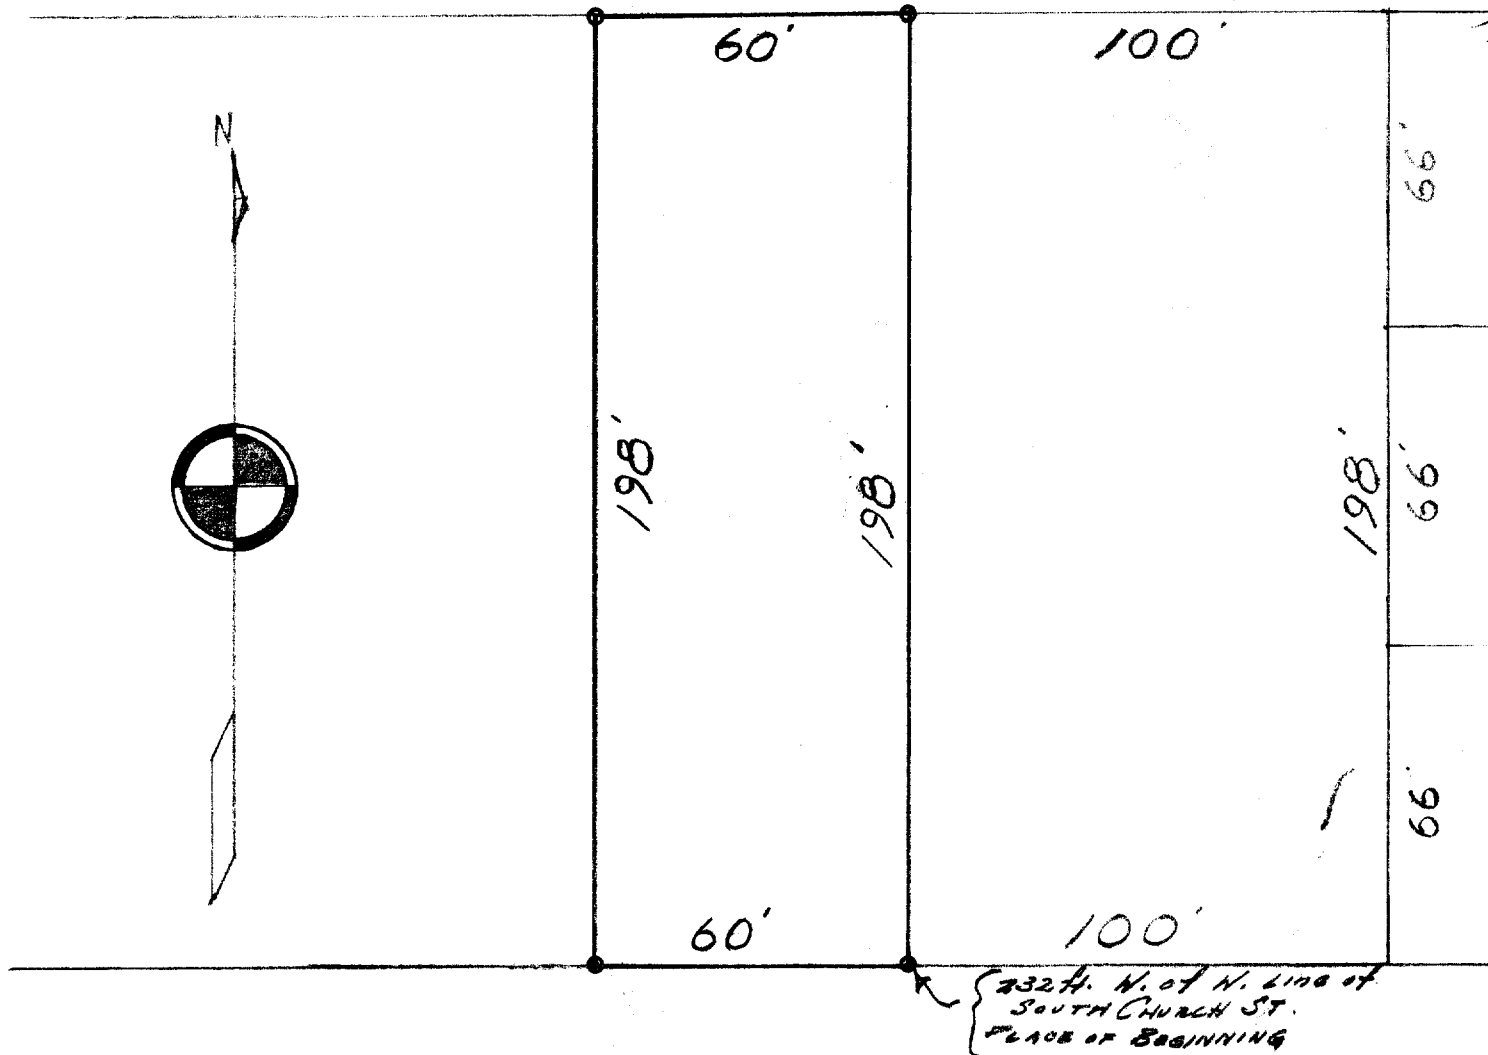


54-9

54-9  
1-2-1-3

WEST CENTRAILIA STREET

## DESCRIPTION:

Commencing at a point in the north line of West Centraillia Street of the City of Elkhorn Walworth County, Wisconsin, that is 232.0 feet west of the west line of South Church Street, thence North parallel with the west line of said South Church Street, 198.0 feet to a point, thence West parallel with the north line of West Centraillia Street, 60.0 feet to a point, thence South parallel with the west line of South Church Street 198.0 feet to a point in the north line of West Centraillia Street, thence East in the north line of West Centraillia Street 60.0 feet to the place of beginning.

## CERTIFICATE:

I, hereby certify that I have on this the 20th day of May, 1954, surveyed the above described property and that the measurements are correct and that no encroachments exist.

SIGNED AND SEALED ON THIS THE 1ST DAY OF JUNE 1954.

Joseph M. Blagi, Professional Engineer.  
Elkhorn Wisconsin.

4-18-7B

4-18-7B

4-18-7B