


PLAT OF SURVEY

LOT 80, HARVEST POINTE, being a part of Lot 4 of Certified Survey Map No. 2083, and a part of the Northeast 1/4, Northwest 1/4, Southeast 1/4 and the Southwest 1/4 of the Southwest 1/4 of Section 30, Town 3 North, Range 17 East, City of Elkhorn, Walworth County, Wisconsin.

Surveyed for: Shorewest Realtors

Survey address: 851 sandy Lane

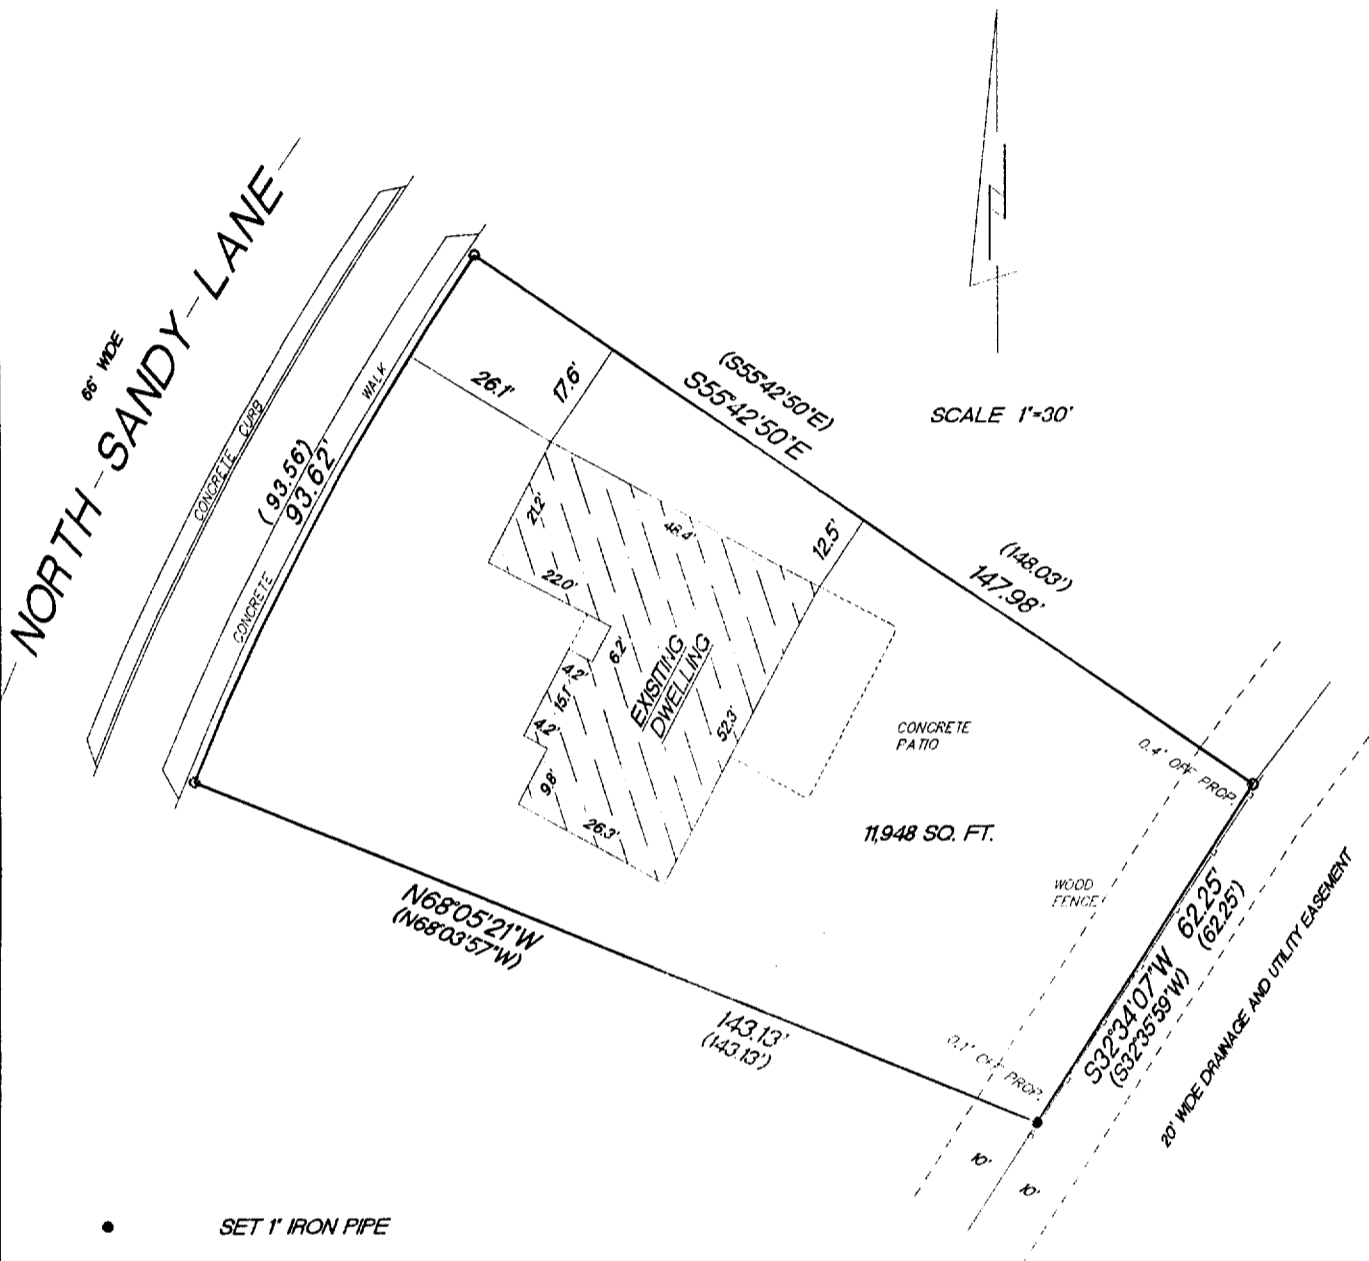

- SET 1" IRON PIPE
- FOUND 1" IRON PIPE
- () RECORDED AS DIMENSIONS

MEASURED CURVE DATA

RADIUS	LENGTH	CHORD	BEARING	DELTA
434.00'	93.62'	93.44'	N28°07'11"E	12°21'34"

RECORDED AS CURVE DATA

RADIUS	LENGTH	CHORD	BEARING	DELTA
434.00'	93.56'	93.38'	N28°06'37"E	12°21'06"

"I hereby certify that I have surveyed the above described property and that the above map is a true representation thereof and shows the size and location of the property, its exterior boundaries, the location of all visible structures and dimension of all principal buildings thereon, boundary fences, apparent easements, roadways and encroachments if any."

"This survey is made for the use of the present owners of the property, and also those who purchase, mortgage or guarantee the title thereto within one year from date hereof."

KETTLE MORaine SURVEYING INC.


W356 S9050 Godfrey Lane

Eagle Wisconsin 53119

P.O. Box 357

(262) 594-3484

Terrance E. Pisarek R.L.S.

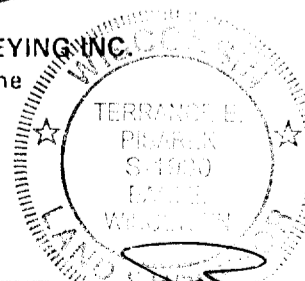

THIS IS NOT AN ORIGINAL SURVEY UNLESS THE SEAL IS RED.

5/20/05

DATE

TEP

FIELD WORK BY

TEP

DRAWN BY

05082

JOB NUMBER

44P 00080

004-1891