PLAT OF SURVEY

April 20, 2005

LOCATION: 700 S. Woodpine Drive, Elkhorn, Wisconsin


Survey No. 050059R Infinity Builders, Inc. Molly Tikalsky and Brandon Claypool

LEGAL DESCRIPTION:

Lot 159 in **THE PINES**, Located in the Northwest 1/4, Northeast 1/4, Southwest 1/4 and Southeast 1/4 of the Southwest 1/4 and Southeast 1/4 of the Southwest 1/4 of Section 5, Town 2 North, Range 17 Eat, City of Elkhorn, Walworth County, Wisconsin.

SHR

SCALE: 1"=30'

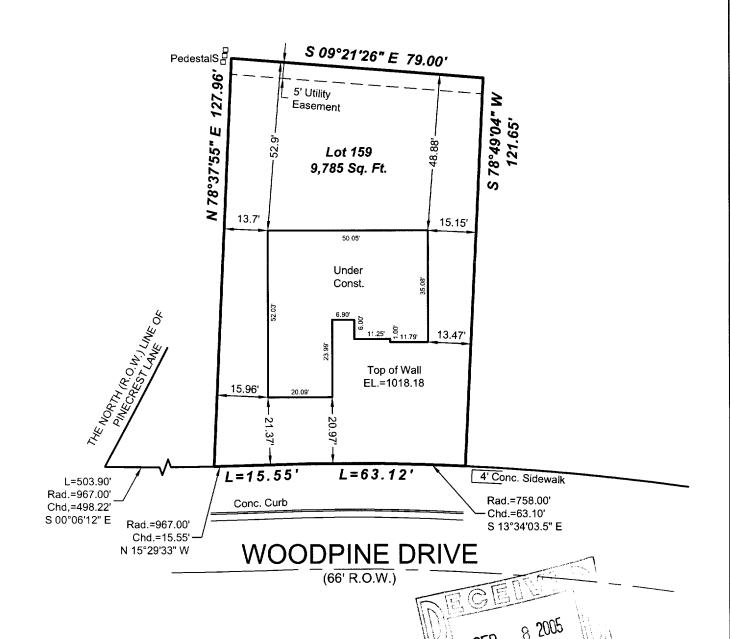


LANDCRAFT SURVEY AND ENGINEERING, INC.

REGISTERED LAND SURVEYORS AND CIVIL ENGINEERS 2077 South 116th Street, West Allis, WI 53227 PH. (414) 604-0674 FAX (414) 604-0677 INFO@LANDCRAFTSE.COM

Mortgage Inspection

Monumentation has been waived in accordance with A-5 5.01 (b) of the Wisconsin Administrative Code.

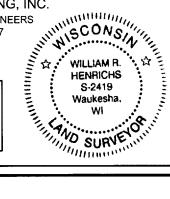

I HEREBY CERTIFY THAT I HAVE SURVEYED THE ABOVE DESCRIBED PROPERTY AND THAT THE ABOVE MAP IS A TRUE REPRESENTATION THEREOF AND SHOWS THE SIZE AND LOCATION OF THE PROPERTY. IS EXTERIOR BOUNDARIES, THE LOCATION OF ALL VISIBLE STRUCTURES AND DIMENSIONS OF ALL PRINCIPAL BUILDINGS THEREON, BOUNDARY FENCES, APPARENT EASEMENTS AND ROADWAYS AND VISIBLE ENCROACHMENT, IF ANY.

DRAWING BY: AW FIELD WORK BY: RT

THIS SURVEY IS MADE FOR THE EXCLUSIVE USE OF THE PRESENT OWNERS OF THE PROPERTY, AND ALSO THOSE WHO PURCHASE. MORTGAGE, OR GUARANTEE THE TITLE THERETO WITHIN ONE (1) YEAR FROM THE DATE HEREOF.

SIGNED Helliam & Henrichs, Registered Land Surveyor S-2419

I 00159