
PREPARED FOR: EILEEN FITZGERALD 202 PARK STREET ELKHORN, WI 53121

## PLAT OF SURVEY

OF-

LOT 20 OF STONEGATE FARMS, A SUBDIVISION LOCATED IN PART OF THE NORTHWEST 1/4 AND THE SOUTHWEST 1/4 OF THE NORTHWEST 1/4 OF SECTION 1, TOWNSHIP 2 NORTH, RANGE 16 EAST, CITY OF ELKHORN, WALWORTH COUNTY, WISCONSIN.

PATHFINDER SURVEYING INC. (formerly) J.K. SURVEYING INC. N3705 WILLOWBEND LANE LAKE GENEVA, WI, 53147 262-248-3697

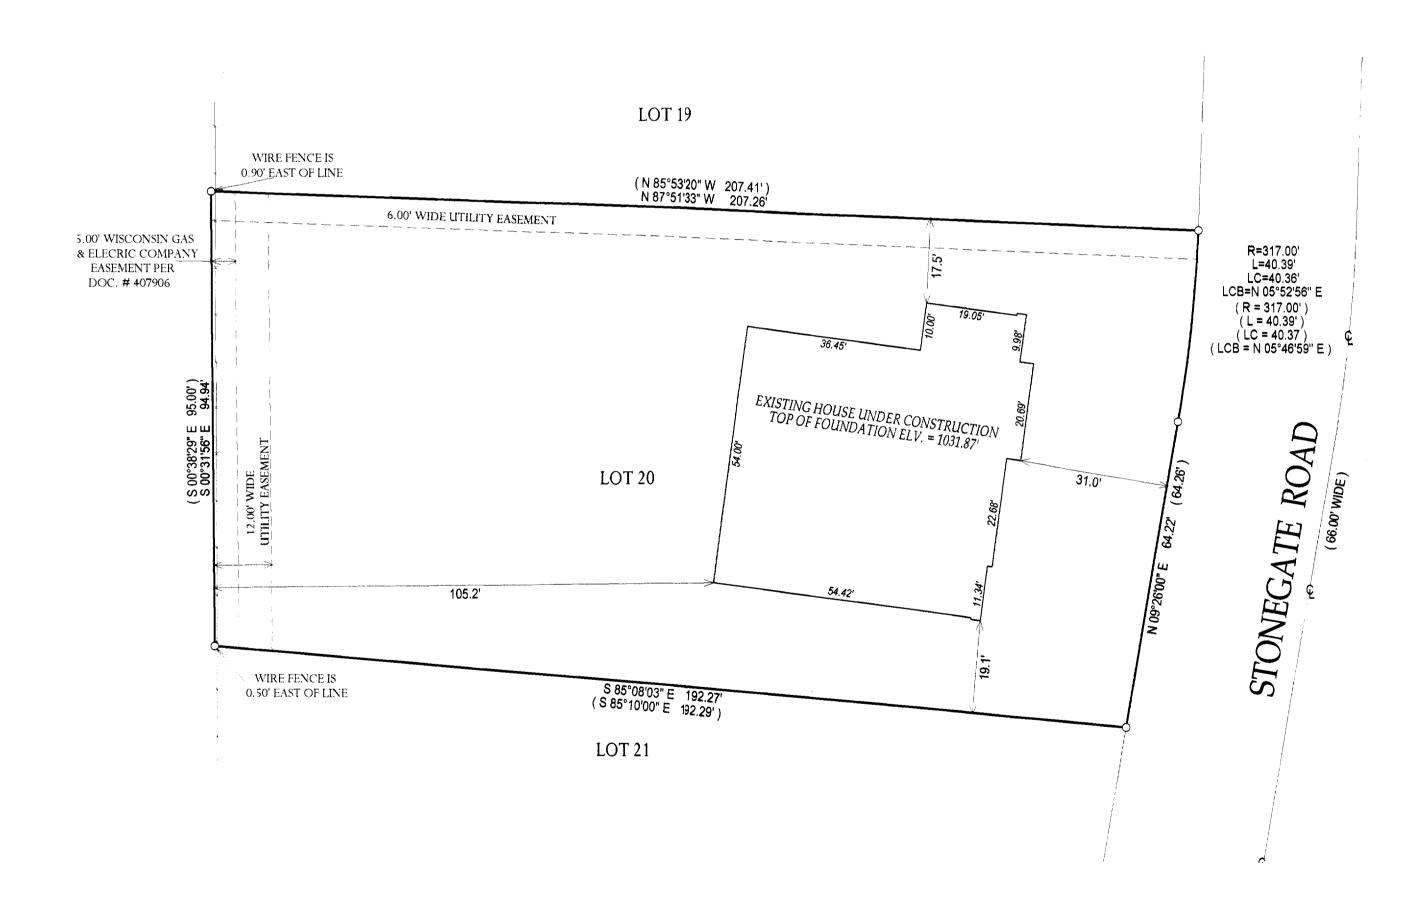



() = recorded as

 $\Box$  = found iron bar


= found iron pipe

= set iron pipe

SCALE: 1" = 20'

JOB #: 05-310AB

TAX ID #: YSF 00020

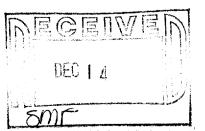

COMPARE LEGAL DESCRIPTION ABOVE AND DRAWING WITH DEED. FOR BUILDING RESTRICTIONS AND EASEMENTS NOT SHOWN, REFER TO DEED, ABSTRACT SOURCES AND LOCAL MUNICIPAL CODES. NOTIFY THE SURVEYOR IMMEDIATELY OF ANY DISCREPANCY.

"I hereby certify that I have surveyed the above described property and that the above map, to the best of my knowledge and belief, is a true representation thereof and shows the size and location of all visible structures, apparent easements and encroachmentsif any." This survey is made for the present owners of the property, and those who purchase, mortgage, or guarentee the title thereto, within one year from the date hereof.

NOTE: BASIS OF BEARING IS RECORD PLAT.

DATE OF LAST REVISION 08-18-05 DATED THIS 27th, DAY OF JUNE, 2005.

JOHN KROTT S - 2258
Wisconsin Registered Land Surveyor
( original if signed in red)