

LAND-MARK SURVEYING

Mark L. Miritz


Wisconsin Registered Land Surveyor S-2582

N9330 Knuteson Drive
Whitewater, WI 53190
Phone: (262) 495-3284
FAX : (262) 495-8421

LAND-MARKSURVEYING.COM


PLAT OF SURVEY

**LOT 48 OF JACKSON CREEK EAST SUBDIVISION,
LOCATED IN THE SW AND SE 1/4'S OF THE SW 1/4
OF SECTION 7, TOWN 2 NORTH, RANGE 17 EAST,
CITY OF ELKHORN, WALWORTH COUNTY, WISCONSIN.**

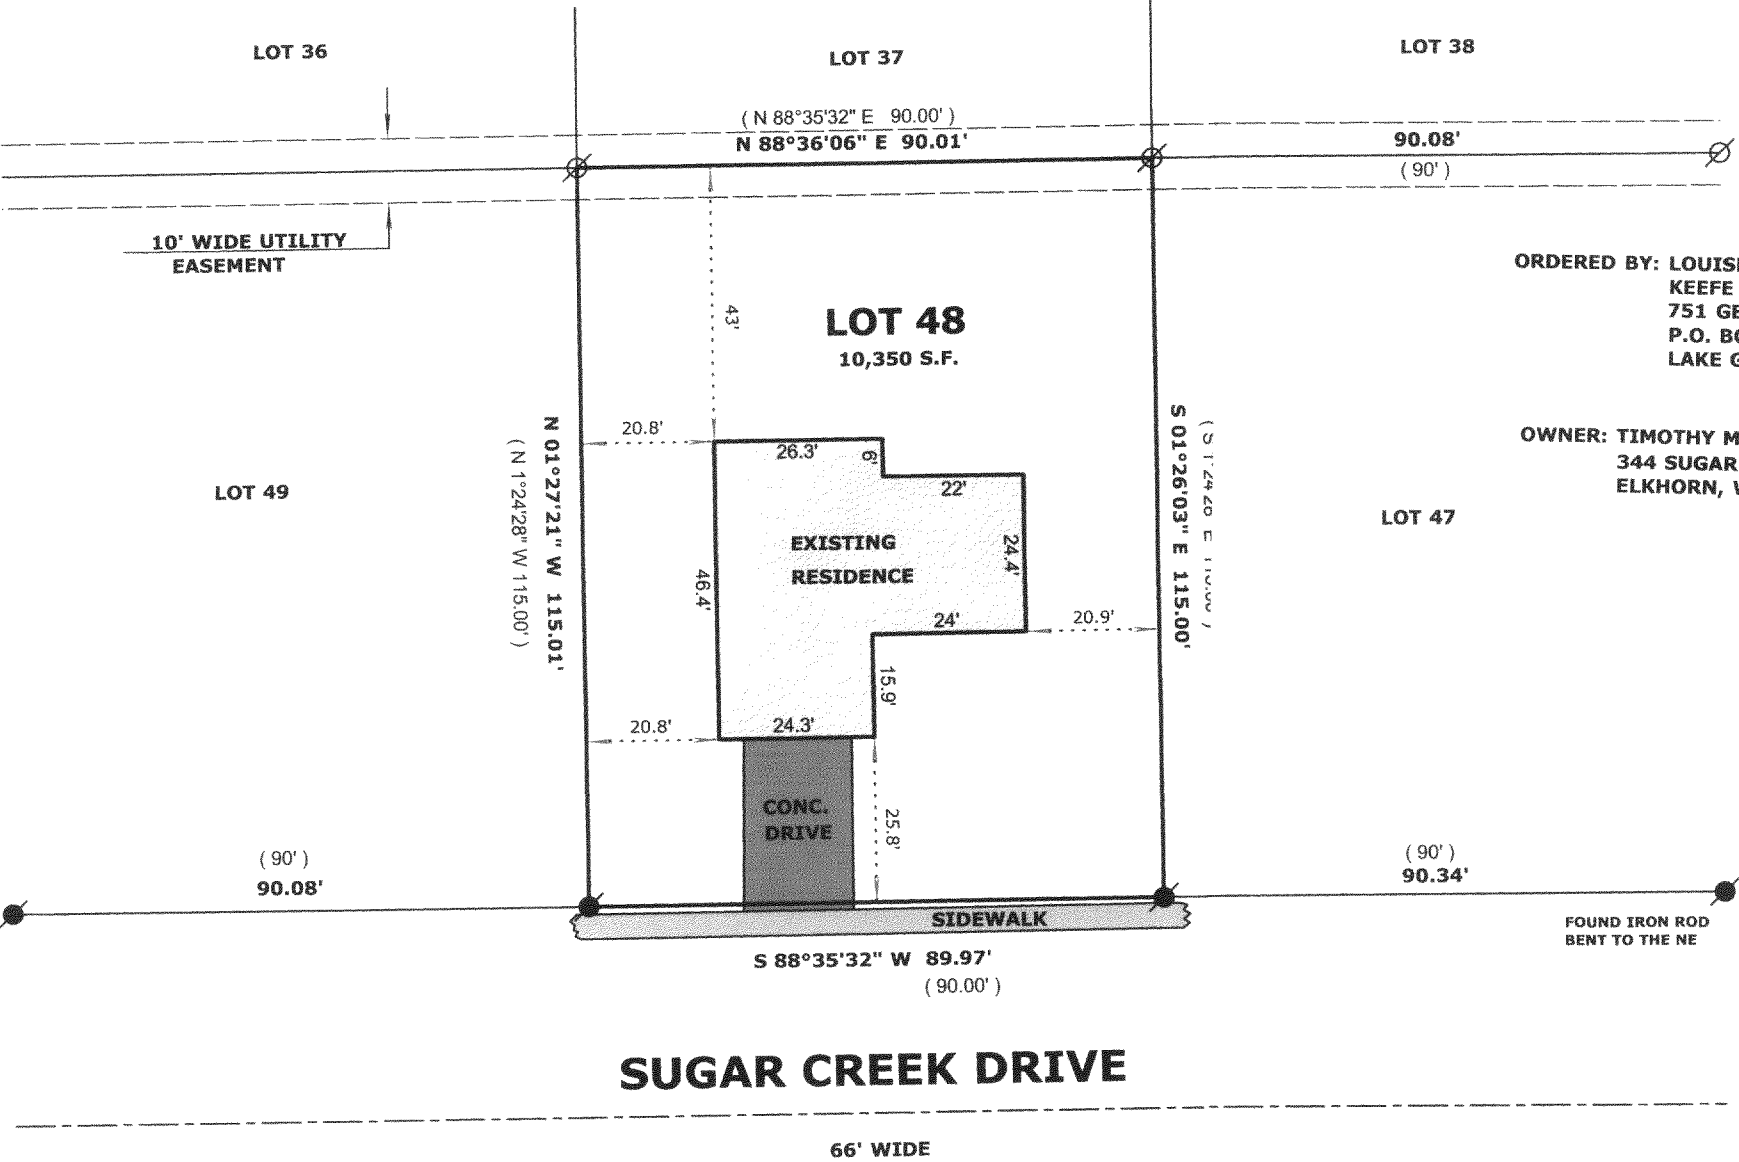

ORDERED BY: LOUISE SHEYKER
KEEFE REAL ESTATE
751 GENEVA PARKWAY
P.O. BOX 460
LAKE GENEVA, WI. 53147

OWNER: TIMOTHY M. UPTON and LORI L. UPTON
344 SUGAR CREEK DR.
ELKHORN, WI. 53121

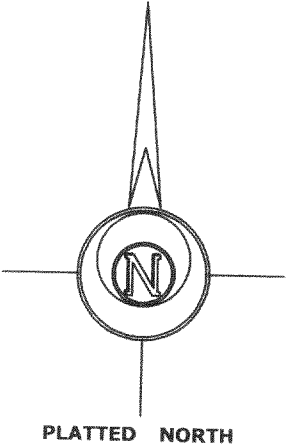


LEGEND

- FOUND IRON PIPE
- FOUND IRON ROD
- FOUND COUNTY MONUMENT
- FOUND CONCRETE MONUMENT
- CHISEL CUT IN CONCRETE
- SET IRON ROD, 24" LONG, WEIGHING 1.5 LBS./LINEAL FT., 3/4" DIA.
- RECORDED AS DIMENSION
- EXISTING FENCE

SCALE: 1" = 30 FEET

"I hereby certify that the above described property has been surveyed by me or under my direction and that the above map is a true representation thereof and shows the size and location of the property, its exterior boundaries, the location of all visible structures and dimensions of all principal buildings thereon, boundary fences, apparent easements, roadways and visible encroachments, if any."
"This survey is made for the use of the present owners of the property, and also those who purchase, mortgage, or guarantee the title thereto within one year from date hereof."

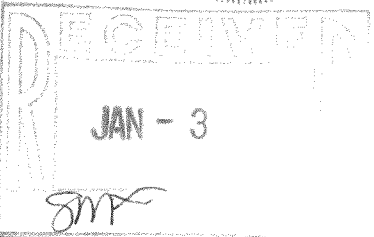

Mark L. Miritz
MARK L. MIRITZ
WISCONSIN REGISTERED
LAND SURVEYOR S-2582

DATE: DEC. 27, 2005 JOB NO. 05.1207

KJCE-48

004-1973