
## PLAT OF SURVEY BEING ALL OF LOT 52 OF HARVEST POINTE SOUTH, LOCATED IN THE SW 1/4 OF

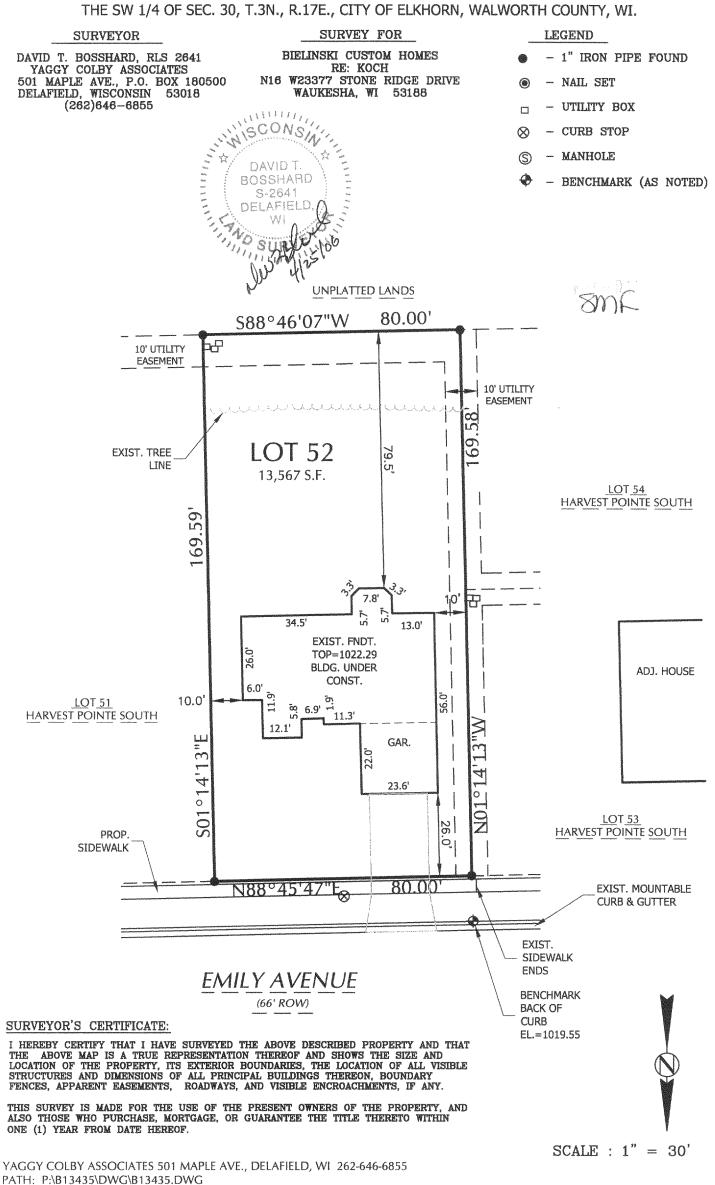

YHPS-52

004-2035