## FARRIS, HANSEN & ASSOCIATES, INC.


ENGINEERING — ARCHITECTURE — SURVEYING
7 RIDGWAY COURT — P.O. BOX 437 — ELKHORN, WISCONSIN 53121

PHONE: (262) 723-2098 FAX: (262) 723-5886

## PLAT OF SURVEY

THE SOUTH 53.05 FEET OF LOT 4, BLOCK 49 OF ROCKWILLS 2ND ADDITION, CITY OF ELKHORN, WALWORTH COUNTY, WISCONSIN

WORK ORDERED BY –
 LISA DENIUS
 203 SOUTH WASHINGTON STREET
 ELKHORN, WI 53121

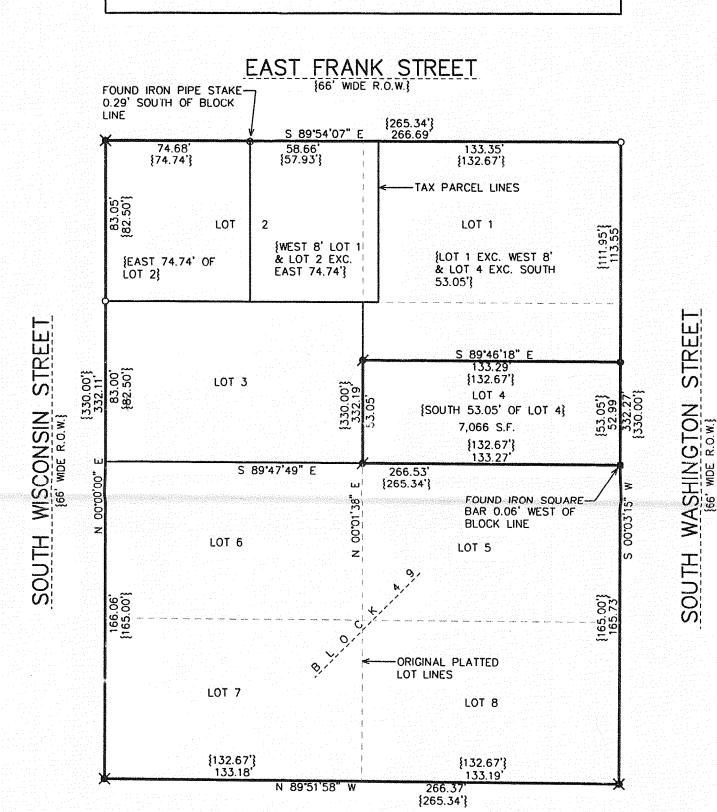

CENTRALIA STREET
[66' WIDE R.O.W.]


100 90 80 70 60 50 40 30 20 10 0 50 100 MAP SCALE IN FEET ORIGINAL 1" = 50'

NOTE: COPIES OF THIS MAP TO WHICH THE FOLLOWING CERTIFICATE WILL APPLY SHOW THE SURVEYOR'S ORIGINAL SEAL AND SIGNATURE IN RED INK. COPIES BY ANY OTHER MEANS MAY HAVE ALTERATIONS WHICH DO NOT REPRESENT THE SURVEYOR'S WORK PRODUCT.

I HEREBY CERTIFY THAT THE ABOVE DESCRIBED PROPERTY HAS BEEN SURVEYED UNDER MY DIRECTION AND THAT THE ABOVE MAP IS A TRUE REPRESENTATION THEREOF AND SHOWS THE SIZE AND LOCATION OF THE PROPERTY AND ITS EXTERIOR BOUNDARIES. THIS SURVEY IS MADE FOR THE USE OF THE PRESENT OWNERS OF THE PROPERTY, AND ALSO THOSE WHO PURCHASE, MORTGAGE, OR GUARANTEE THE TITLE THERETO WITHIN ONE YEAR FROM THE DATE HEREOF.

DATED: AUGUST 20, 2007

PETER S. GORDON R.E.S. 2101

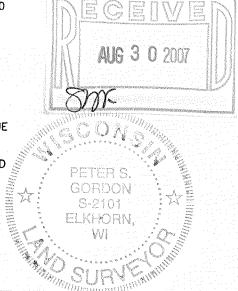

LEGEND

O = FOUND IRON PIPE STAKE

■ = FOUND CHISELED "X"

■ = FOUND SQUARE ROD

= FOUND IRON REBAR STAKE

= SET IRON REBAR STAKE

{XXX} = RECORDED AS

PROJECT: 7399 DATE: 8/20/2007 SHEET 1 OF 1

004-2162

YRWA - 20

AUG 2 2 2007

202

(SUP)