

Plat of Survey

of

Lot 24 of Harvest Pointe,

a subdivision located in the Southwest 1/4 of Section 30,
Town 3 North, Range 17 East, City of Elkhorn,
Walworth County, Wisconsin.

Surveyed for: **Jeremiah & Amy Nelson**

W140 S9115 Boxhorn Drive
Muskego, Wisconsin. 53150



Notes: 1) This survey plat is not
certified unless signed
and sealed in red ink.

2) This survey is subject to Wisconsin lien laws.
This Plat of Survey is the notice of intent
to file lien. Lien waiver required.


Copyright © 2007 by Jensen & Olson Land Surveying, LLC.

All rights reserved. No part of this survey plat may be reproduced
or transmitted in any form by any means - graphic, electronic, or
mechanical, including photocopying, tracing, or information storage
and retrieval systems - without permission in writing from Douglas
G. Olson, Jensen & Olson Land Surveying, LLC.

I hereby certify that I have surveyed the above described
property and the map hereon is correct to the best of my professional
knowledge and belief and shows the size and location of the property,
its exterior boundaries, the location and dimensions of all visible
structures thereon, boundary fences, apparent easements and roadways
and visible encroachments, if any.
This survey is made for the exclusive use of the present owners
of property, and also those who purchase, mortgage or guarantee title
thereto, within one year from the date hereof.

Douglas G. Olson
Wisconsin Registered Land Surveyor - 2093

Kelly
Lane

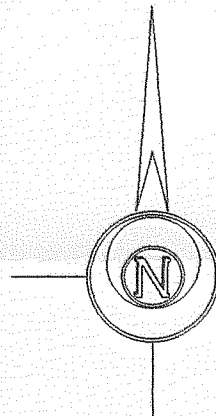

Bearings reference to the
plat of Harvest Pointe.

Lot 25

Lot 26

Lot 24
0.318 Acre
13,870 Sq.Ft.


House
No. 822

Lot 23

North
Susan
Court

East Market Street

Heather Drive

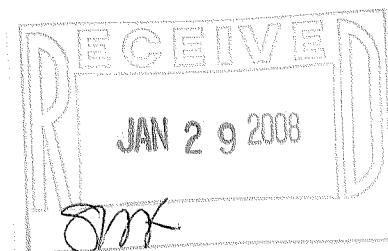

Survey Date: August 21, 2007.

Revisions:

Scale in Feet

1" = 20'



Jensen & Olson Land Surveying, LLC

45 South Wisconsin Street P.O. Box 322

Elkhorn, Wisconsin. 53121

Telephone (262) 723-3434

Facsimile (262) 723-8044

Legend

- Found Iron Pipe
- Found 100d Spike
- Set Iron Rod 3/4" dia.
- Recovered Iron Rod
- Utility Pole
- Catch Basin
- Manhole
- Asphalt Surface
- Concrete
- Water Valve

Sheet 1 of 1 Sheets

Job Reference Number

2007.112

2007.112

YHP - 24

004-2187