
DUNHAM & RASMUSSEN SURVEYING & ENGINEERING DELAVAN, WISCONSIN

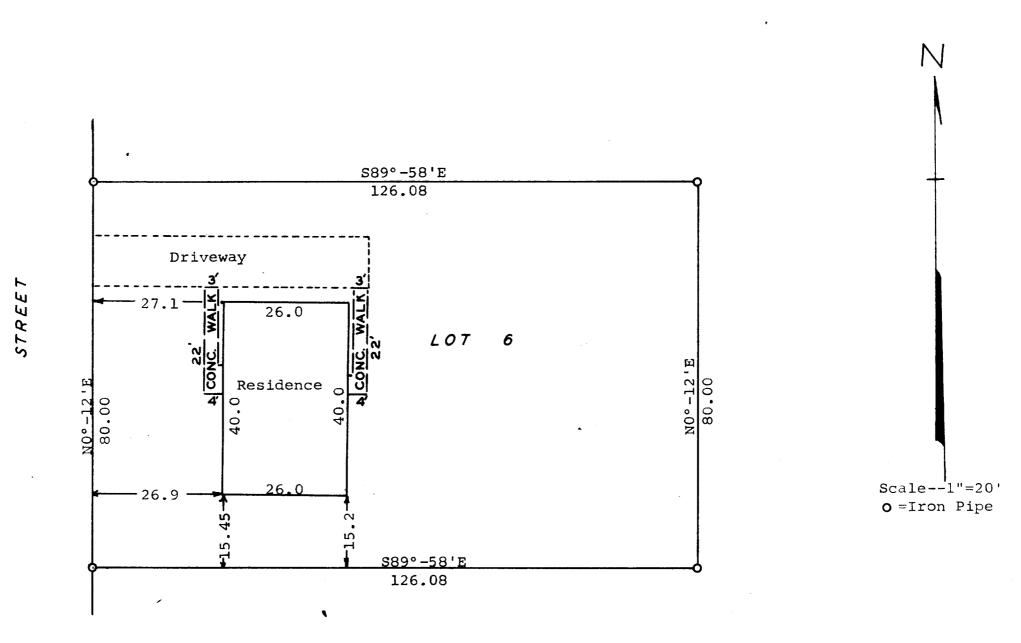

STATE OF WISCONSIN) WALWORTH COUNTY)SS

I, George T. Dunham do hereby certify that I have surveyed the property described as follows,

> Lot 6 of Landmark Subdivision located in the Southwest 4 of Section 36, T 3 N, R 16 E, City of Elkhorn, Walworth County, Wisconsin

lines and of the improvements located thereon.

4-22

YC56