

PREPARED FOR
 GEOFF ENGERMAN
 ENGERMAN REAL ESTATE
 W3411 HWY. "BB"
 LAKE GENEVA WI. 53147



PLAT OF SURVEY

-OF-

KROTT SURVEYING INC.

N3705 WILLOW BEND LANE
 LAKE GENEVA WI. 53147
 PHONE # (262)248-3697
 FAX # (262)249-0639

LOT 3, OF CERTIFIED SURVEY 1346 AS RECORDED IN
 VOLUME 6 OF CERTIFIED SURVEYS ON PAGE 178,
 WALWORTH COUNTY RECORDS. LOCATED IN THE SE
 1/4 OF THE NW 1/4 OF SECTION 6, TOWN 2 NORTH,
 RANGE 17 EAST. CITY OF ELKHORN, WALWORTH
 COUNTY, WISCONSIN.

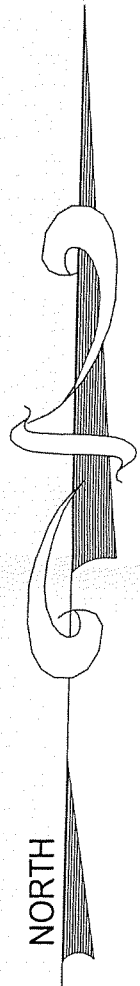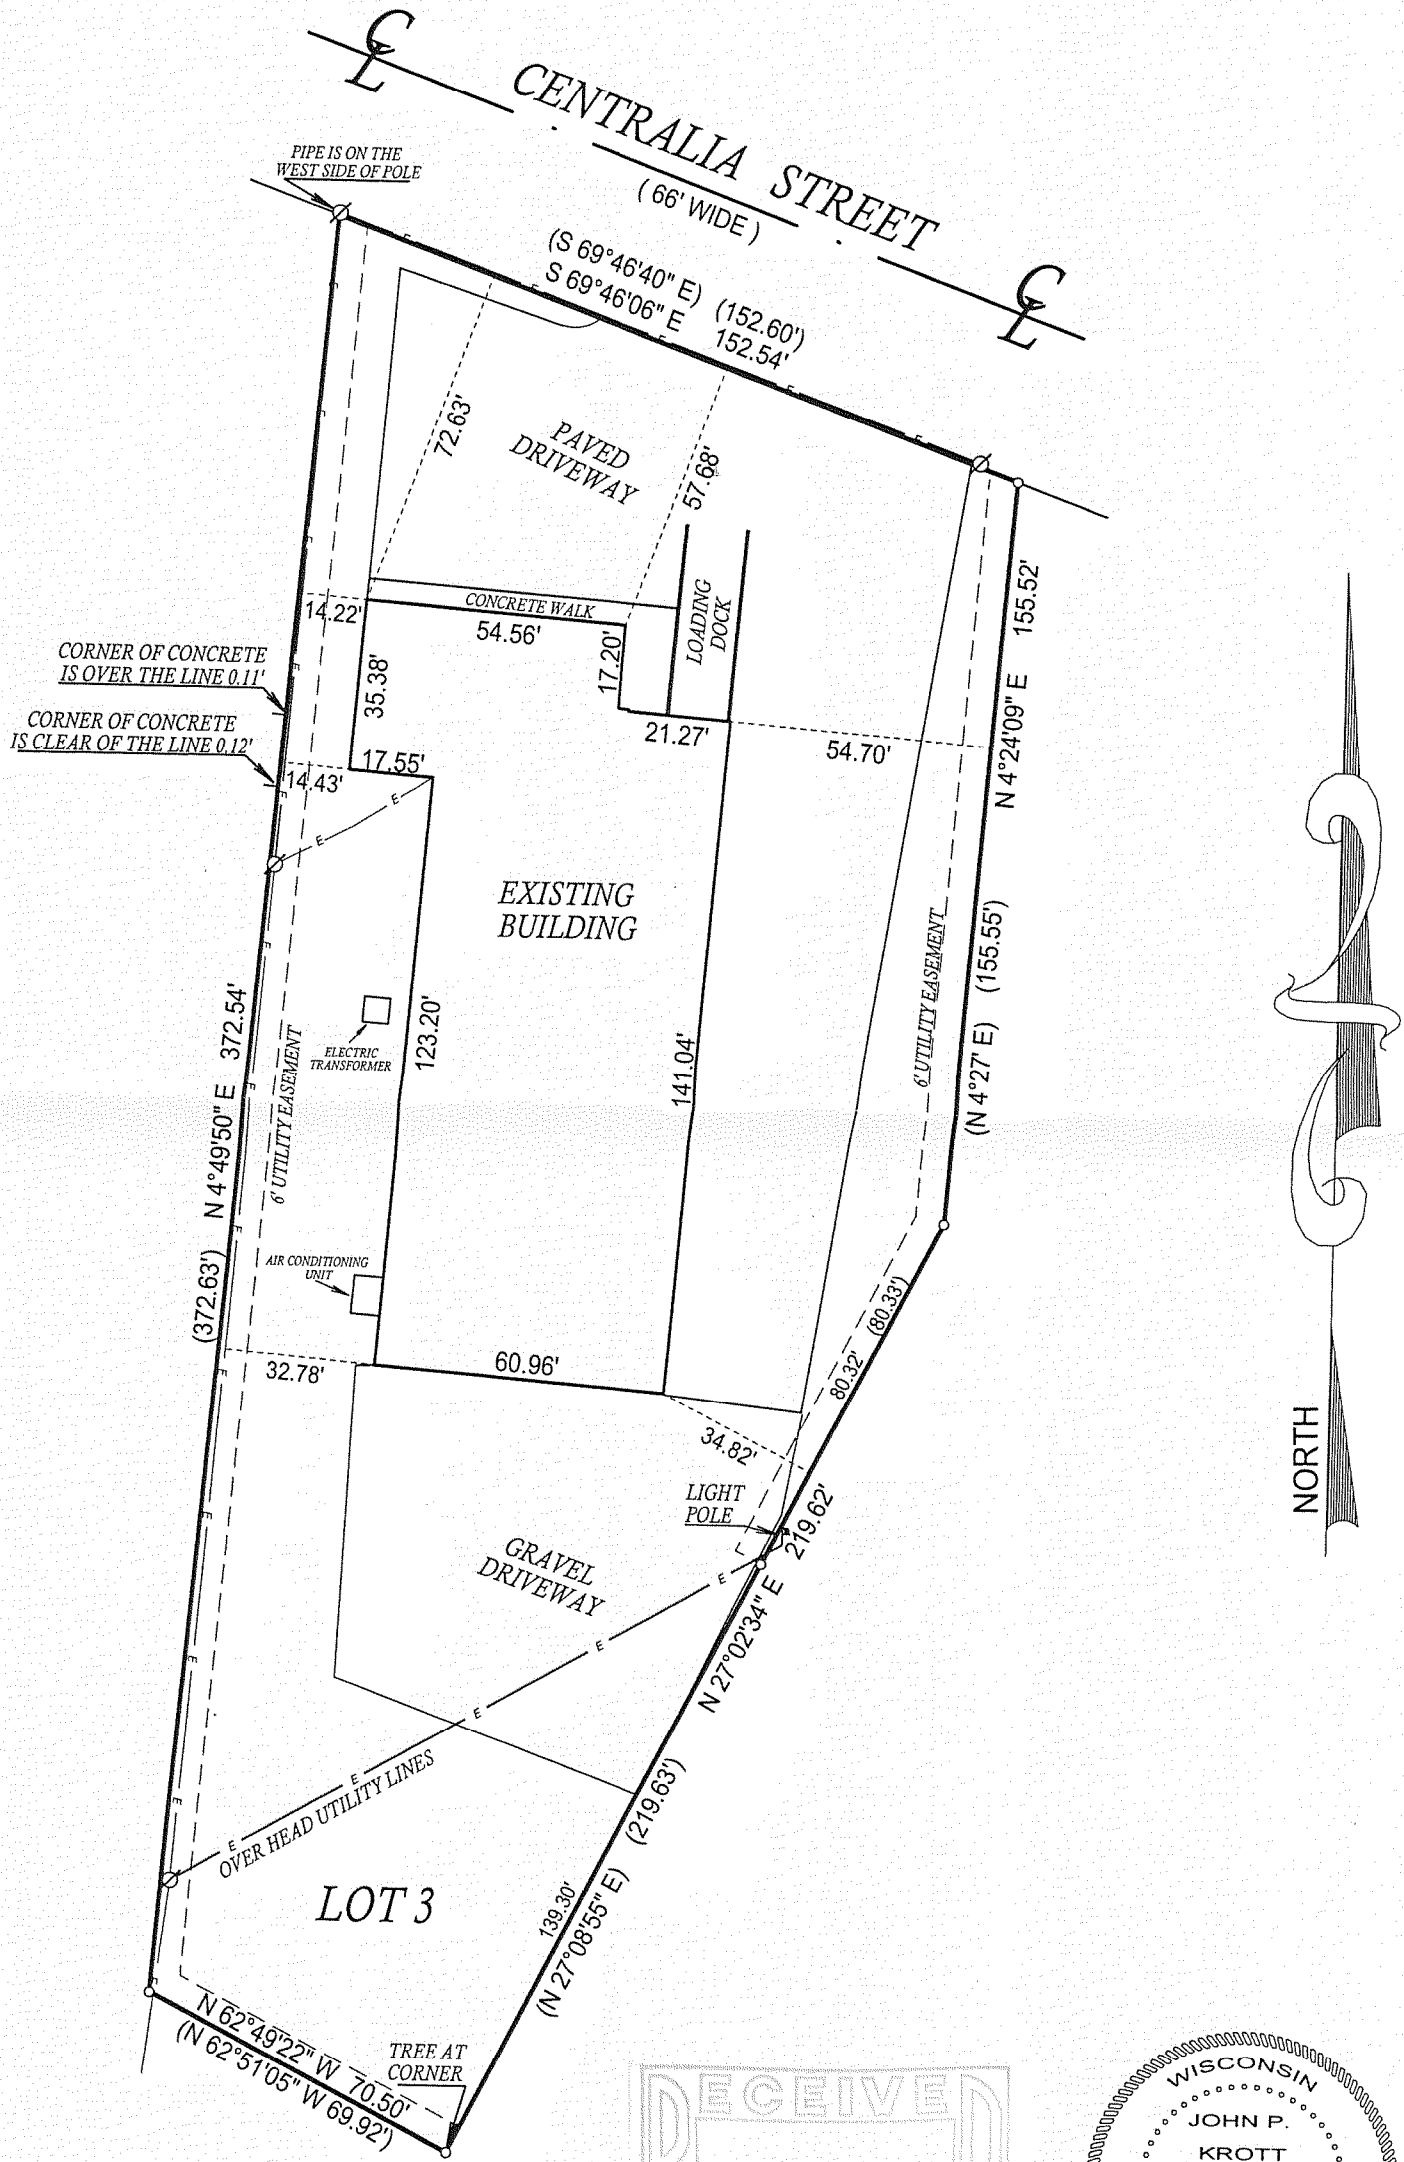



- () = recorded as
 - = found iron bar
 - = found iron pipe
 - = set iron pipe
 - = set iron bar
 - ⊙ = power pole
- SCALE 1" = 40'

JOB # 02-145UD
 TAX ID # YA134600003

COMPARE LEGAL DESCRIPTION ABOVE AND DRAWING WITH DEED.
 FOR BUILDING RESTRICTIONS AND EASEMENTS NOT SHOWN, REFER
 TO DEED, ABSTRACT SOURCES AND LOCAL MUNICIPAL CODES. NOTIFY
 THE SURVEYOR IMMEDIATELY OF ANY DISCREPANCY.

"I hereby certify that I have surveyed the above described property and that
 the above map is a true representation thereof and shows the size and
 location of all visible structures, apparent easements and encroachments
 if any."

This survey is made for the present owners of the property, and those who
 purchase, mortgage, or guarantee the title thereto, within one year from
 the date hereof.

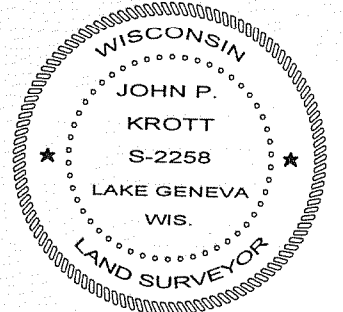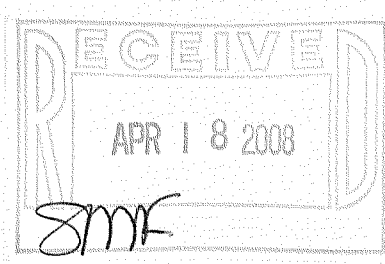

John P. Krott
 JOHN KROTT S - 2258
 Wisconsin Registered Land Surveyor
 (original if signed in red)

004-2201