
ENGINEERING — ARCHITECTURE — SURVEYING 7 RIDGWAY COURT — P.O. BOX 437 — ELKHORN, WISCONSIN 53121 PHONE: (262) 723—2098 FAX: (262) 723—5886

PLAT OF SURVEY

LOT 149 OF ELKHORN WEST ADDITION NO. 2

WORK ORDERED BY –
DAN CARMODY
5803 GLEN HAVEN DRIVE
GREENDALE, WI. 53129

LOCATED IN PART OF THE NE 1/4 OF THE SE 1/4 OF SECTION 35 TOWN 3 NORTH, RANGE 16 EAST, CITY OF ELKHORN, WALWORTH COUNTY, WISCONSIN

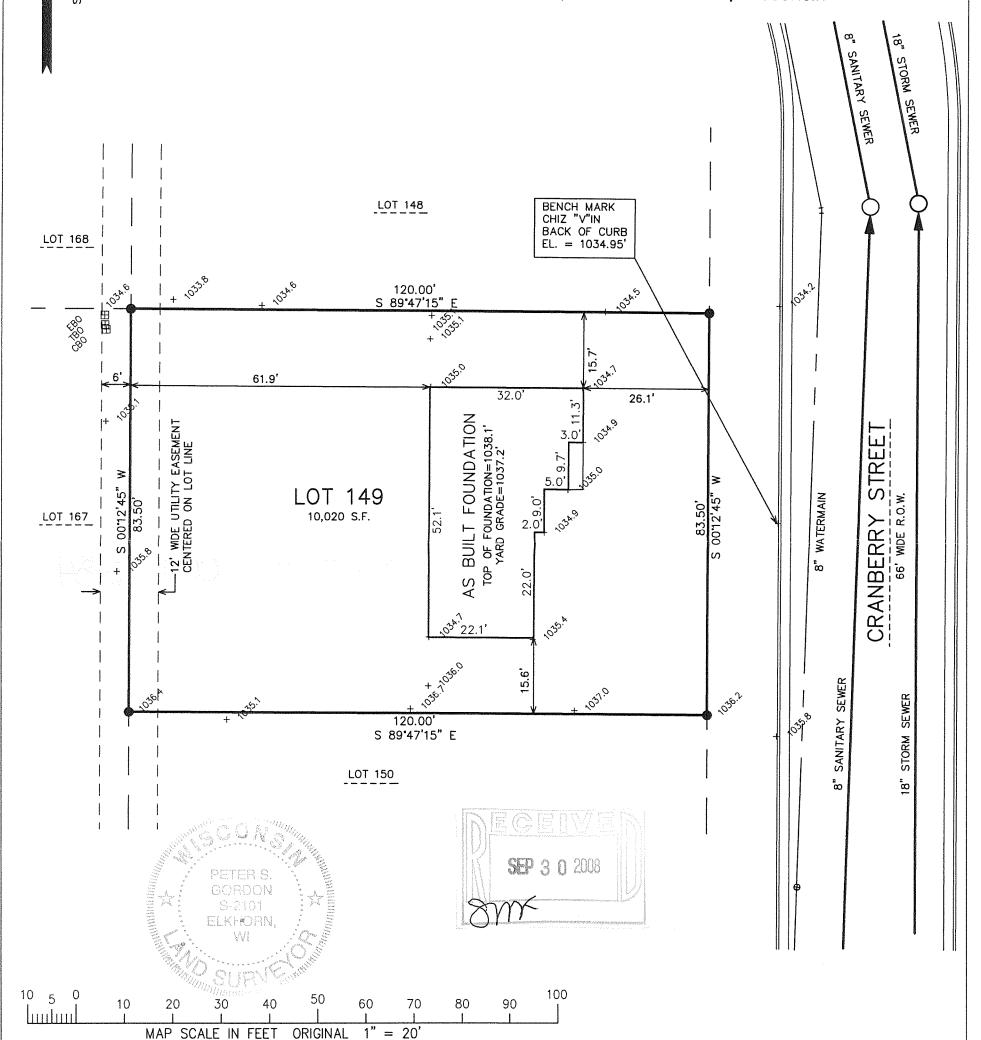

NOTE: COPIES OF THIS MAP TO WHICH THE FOLLOWING CERTIFICATE WLL APPLY SHOW THE SURVEYOR'S ORIGINAL SEAL AND SIGNATURE IN RED INK. COPIES BY ANY OTHER MEANS MAY HAVE ALTERATIONS WHICH DO NOT REPRESENT THE SURVEYOR'S WORK PRODUCT.

I HEREBY CERTIFY THAT THE ABOVE DESCRIBED PROPERTY HAS BEEN SURVEYED UNDER MY DIRECTION AND THAT THE ABOVE MAP IS A TRUE REPRESENTATION THEREOF AND SHOWS THE SIZE AND LOCATION OF THE PROPERTY AND ITS EXTERIOR BOUNDARIES. THIS SURVEY IS MADE FOR THE USE OF THE PRESENT OWNERS OF THE PROPERTY, AND ALSO THOSE WHO PURCHASE, MORTGAGE, OR GUARANTEE THE TITLE THERETO WITHIN ONE YEAR FROM THE DATE

LEGEND

= SET IRON REBAR STAKE

= FOUND IRON PIPE STAKE

(XXX) = RECORDED AS

DATED: SEPTEMBER 15, 2005

REVISED 07-22-2008 TO SHOW SIZE & LOCATION OF PROPOSED RESIDENCE REVISED 09-04-2008 TO SHOW AS BUILT FOUNDATION SIZE & LOCATION

> PROJECT: 6103.02.149 DATE: 09/15/2005 SHEET 1 OF 1

PETER S. GORDON R.L.S. 2101

YEW2-149

1 0001

004 - 2234