

CONTINUOUS MOTION PACKAGING
COUNTRY CLUB PARKWAY
CITY OF ELKHORN, WALWORTH COUNTY, WISCONSIN

FARRIS, HANSEN & ASSOCIATES, INC.
ENGINEERING - ARCHITECTURE - SURVEYING
7 RIDGWAY COURT P.O. BOX 437
ELKHORN, WISCONSIN 53121
OFFICE: (262) 723-2098 FAX: (262) 723-5886

REVISIONS

PROJECT NO.
7081.07


DATE:
02/03/2009

SHEET NO.
1 OF 1

PLAT OF SURVEY



LOT 1 OF CERTIFIED SURVEY MAP NO. 3985

RECORDED IN VOLUME 24 ON PAGE 278 AS DOCUMENT NO. 686184
LOCATED IN PART OF THE SOUTHEAST 1/4 OF THE NORTHEAST 1/4 OF
SECTION 24, TOWN 3 NORTH, RANGE 16 EAST, CITY OF ELKHORN,
WALWORTH COUNTY, WISCONSIN

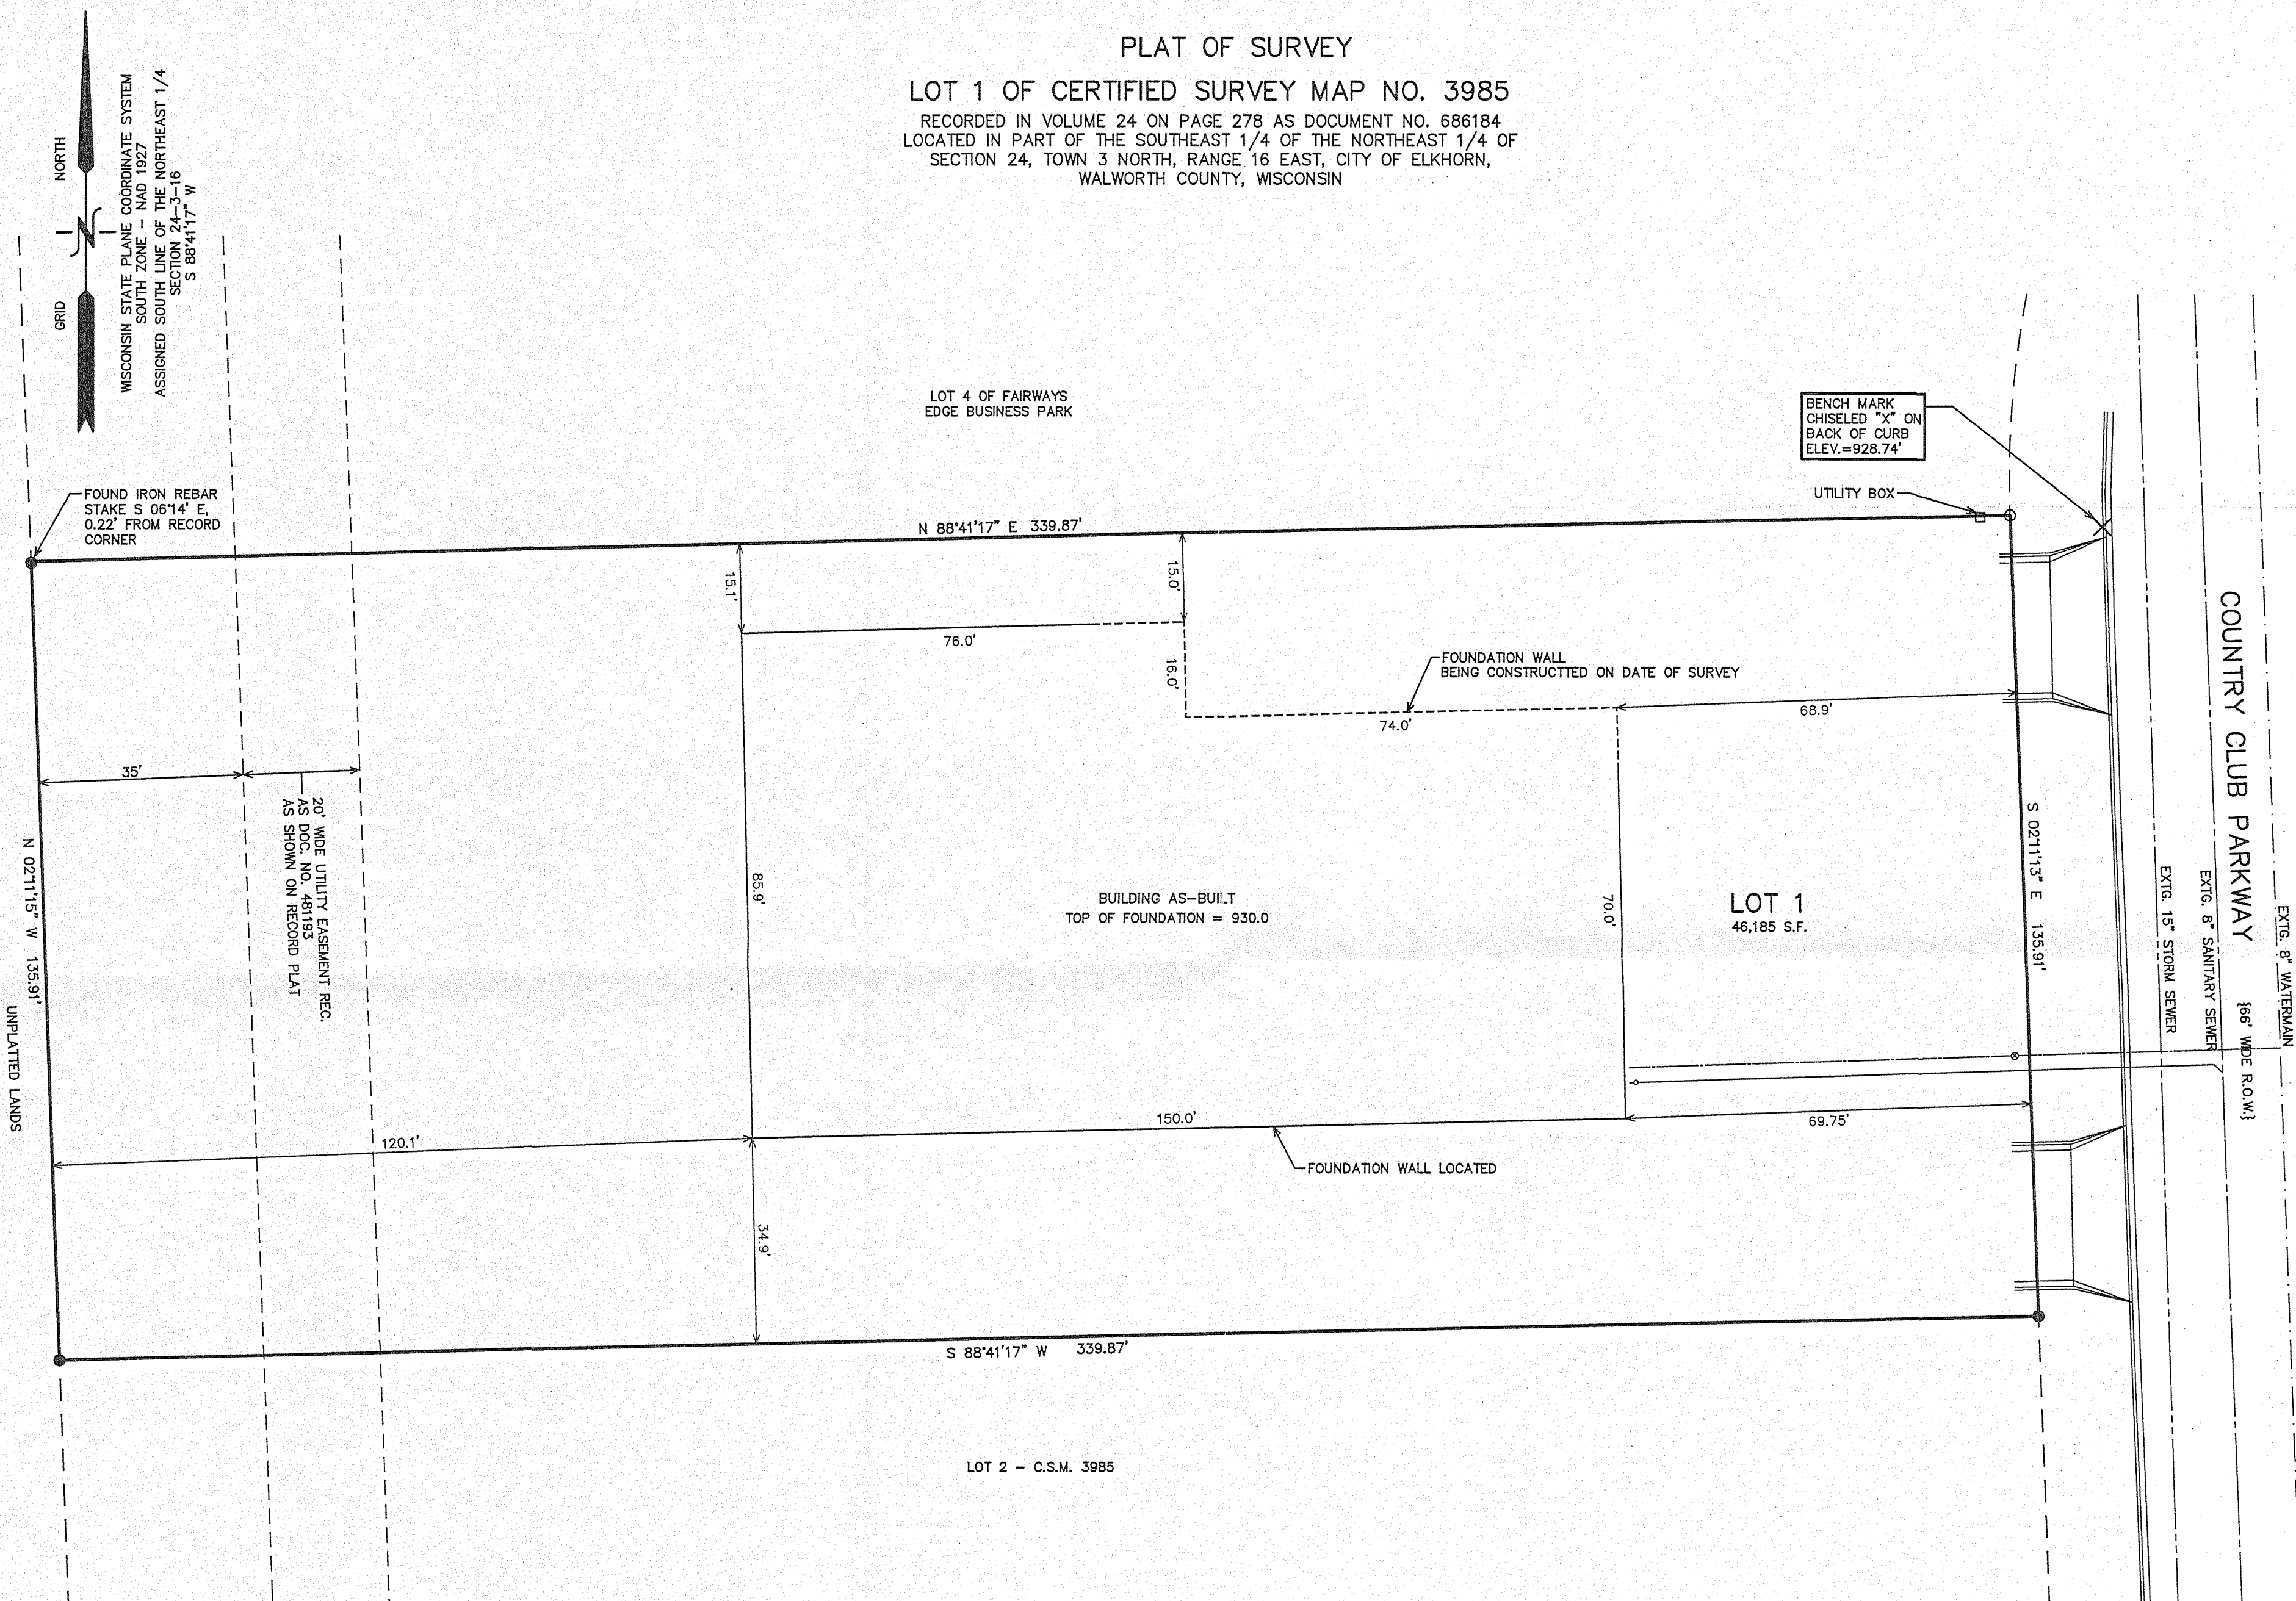

LEGEND
○ = FOUND IRON PIPE STAKE
● = FOUND IRON REBAR STAKE
{xxx} = RECORDED AS

MAP SCALE IN FEET ORIGINAL 1" = 20'

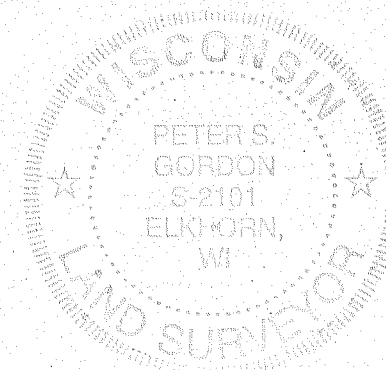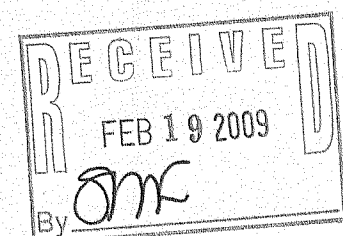

NOTE: COPIES OF THIS MAP TO WHICH THE FOLLOWING CERTIFICATE
WILL APPLY SHOW THE SURVEYOR'S ORIGINAL SEAL AND SIGNATURE
IN RED INK. COPIES BY ANY OTHER MEANS MAY HAVE ALTERATIONS
WHICH DO NOT REPRESENT THE SURVEYOR'S WORK PRODUCT.

I HEREBY CERTIFY THAT THE ABOVE DESCRIBED PROPERTY HAS BEEN
SURVEYED UNDER MY DIRECTION AND THAT THE ABOVE MAP IS A TRUE
REPRESENTATION THEREOF AND SHOWS THE SIZE AND LOCATION OF
THE PROPERTY AND ITS EXTERIOR BOUNDARIES. THIS SURVEY IS
MADE FOR THE USE OF THE PRESENT OWNERS OF THE PROPERTY, AND
ALSO THOSE WHO PURCHASE, MORTGAGE, OR GUARANTEE THE TITLE
THERE TO WITHIN ONE YEAR FROM THE DATE HEREOF.

DATED: JUNE 22, 2007

2/3/2009 - REVISED TO
SHOW BUILDING AS-BUILT

PETER S. GORDON R.L.S. 2101

004-2248

2/3/2009 X:\Projects\7081\Drawn\ASBUILT

YA3985-1