## FARRIS, HANSEN & ASSOCIATES, INC.

ENGINEERING - ARCHITECTURE - SURVEYING 7 RIDGWAY COURT - P.O. BOX 437 - ELKHORN, WISCONSIN

FARLEY NESHEK REALTY CORPORATION
PO BOX 75
53121 ELKHORN, WI 53121

PHONE: (262) 723–2098 FAX: (262) 723–5886

## PLAT OF SURVEY

LEGAL DESCRIPTIO

Lot 37 Fair Meadow Subdivision Addition No. 1, located in part of the Northeast ¼ and the Southeast ¼ of the Northwest 3

DEGEOVE OCT 19 2009

- WORK ORDERED BY -


WISCONSIN STATE PLANE COORDINATE SYSTEM SOUTH ZONE

N. LINE OF THE NW 1/4 OF SEC. 31-3-17
BEARS S 88'45'48" W

NORTH

GRID

Tax Key No. YFM1 00037

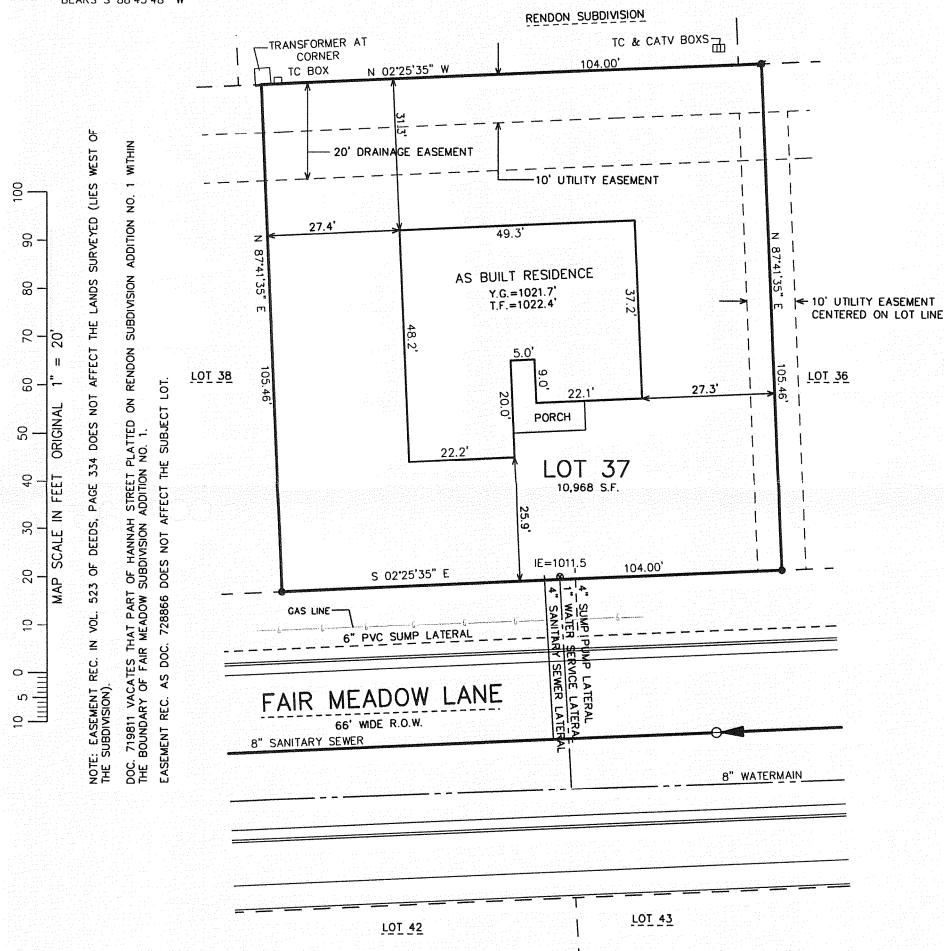

NOTE: COPIES OF THIS MAP TO WHICH THE FOLLOWING CERTIFICATE WILL APPLY SHOW SURVEYOR'S ORIGINAL SEAL AND SIGNATURE IN RED INK. COPIES BY ANY OTHER MEANS MAY HAVE ALTERATIONS WHICH DO NOT REPRESENT THE SURVEYOR'S WORK PRODUCT.

I HEREBY CERTIFY THAT THE ABOVE DESCRIBED PROPERTY HAS BEEN SURVEYED UNDER MY DIRECTION AND THAT THE ABOVE MAP IS A TRUE REPRESENTATION THEREOF AND SHOWS THE SIZE AND LOCATION OF THE PROPERTY, ITS EXTERIOR BOUNDARIES, THE LOCATION OF ALL VISIBLE STRUCTURES, AND DIMENSIONS OF ALL PRINCIPLE BUILDINGS THEREON, BOUNDARY FENCES, APPARENT EASEMENTS, ROADWAYS, AND VISIBLE ENCROACHMENTS, IF ANY. THIS SURVEY IS MADE FOR THE USE OF THE PRESENT OWNERS OF THE PROPERTY, AND ALSO THOSE WHO PURCHASE, MORTGAGE, OR GUARANTEE THE TITLE THERETO WITHIN ONE YEAR FROM THE DATE HEREOF.

= FOUND IRON REBAR STAKE, 1 5/16" DIA. DATED: SEPTEMBER 24, 2009

PETER S. GORDON R.L.S. 2101

PROJECT: 6104.37 DATE: 07/01/2008 SHEET 1 OF 1

William of the world

GORDON

S-2101

ELKHORN

 $\{XXX\}$  = RECORDED AS

1.50 lbs./ft.

LEGEND

= FOUND IRON PIPE STAKE, 2" DIA.

= SET IRON REBAR STAKES, 3/4" x 24" x

7009 X: \Projects\6104\DCAD\ADDITION\INVIDLOTS\