

PREPARED FOR
STUART ROSENBERG
ICI COMERCIAL
1156 WEST SHURE DRIVE
SUITE 160
ARLINGTON HEIGHTS, IL. 60004

PLAT OF SURVEY

KROTT SURVEYING INC.

N3705 WILLOW BEND LANE
LAKE GENEVA WI. 53147
PHONE # (262)248-3697
FAX # (262)249-0639


-OF-
LOT 1 CERTIFIED SURVEY MAP NO. 3693 AS RECORDED IN
VOLUME 22 OF CERTIFIED SURVEYS ON PAGE 100 AS
DOCUMENT NO. 603911, LOCATED IN THE SOUTHEAST 1/4
OF SECTION 6, TOWN 2 NORTH, RANGE 17 EAST, CITY OF
ELKHORN, WALWORTH COUNTY, WISCONSIN.

RECEIVED
DEC 23 2009
By *SMF*



LEGEND
FOUND IRON PIPE
FOUND IRON BAR
TELEPHONE PEDESTAL
RECORDED AS
ID # YA369300001
09-179

SCALE 1" = 50'
0 50 100 150
I have surveyed the above-described property and the above map is a true representation thereof and shows the size and location of the property, its exterior boundaries, the location and dimensions of all structures thereon, fences apparent easements and roadways and visible encroachments, if any.
This survey is made for the exclusive use of the present owners of the property, and also those who purchase, mortgage, or insure the title thereto within one (1) year from date hereof; and as to them I warrant the accuracy of said survey map.

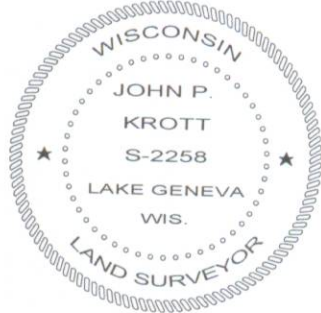

DATED THIS 23rd DAY OF DECEMBER 2009.

John P. Krott
JOHN KROTT S - 2258
Wisconsin Registered Land Surveyor
(original if signed in red)

004-2273