
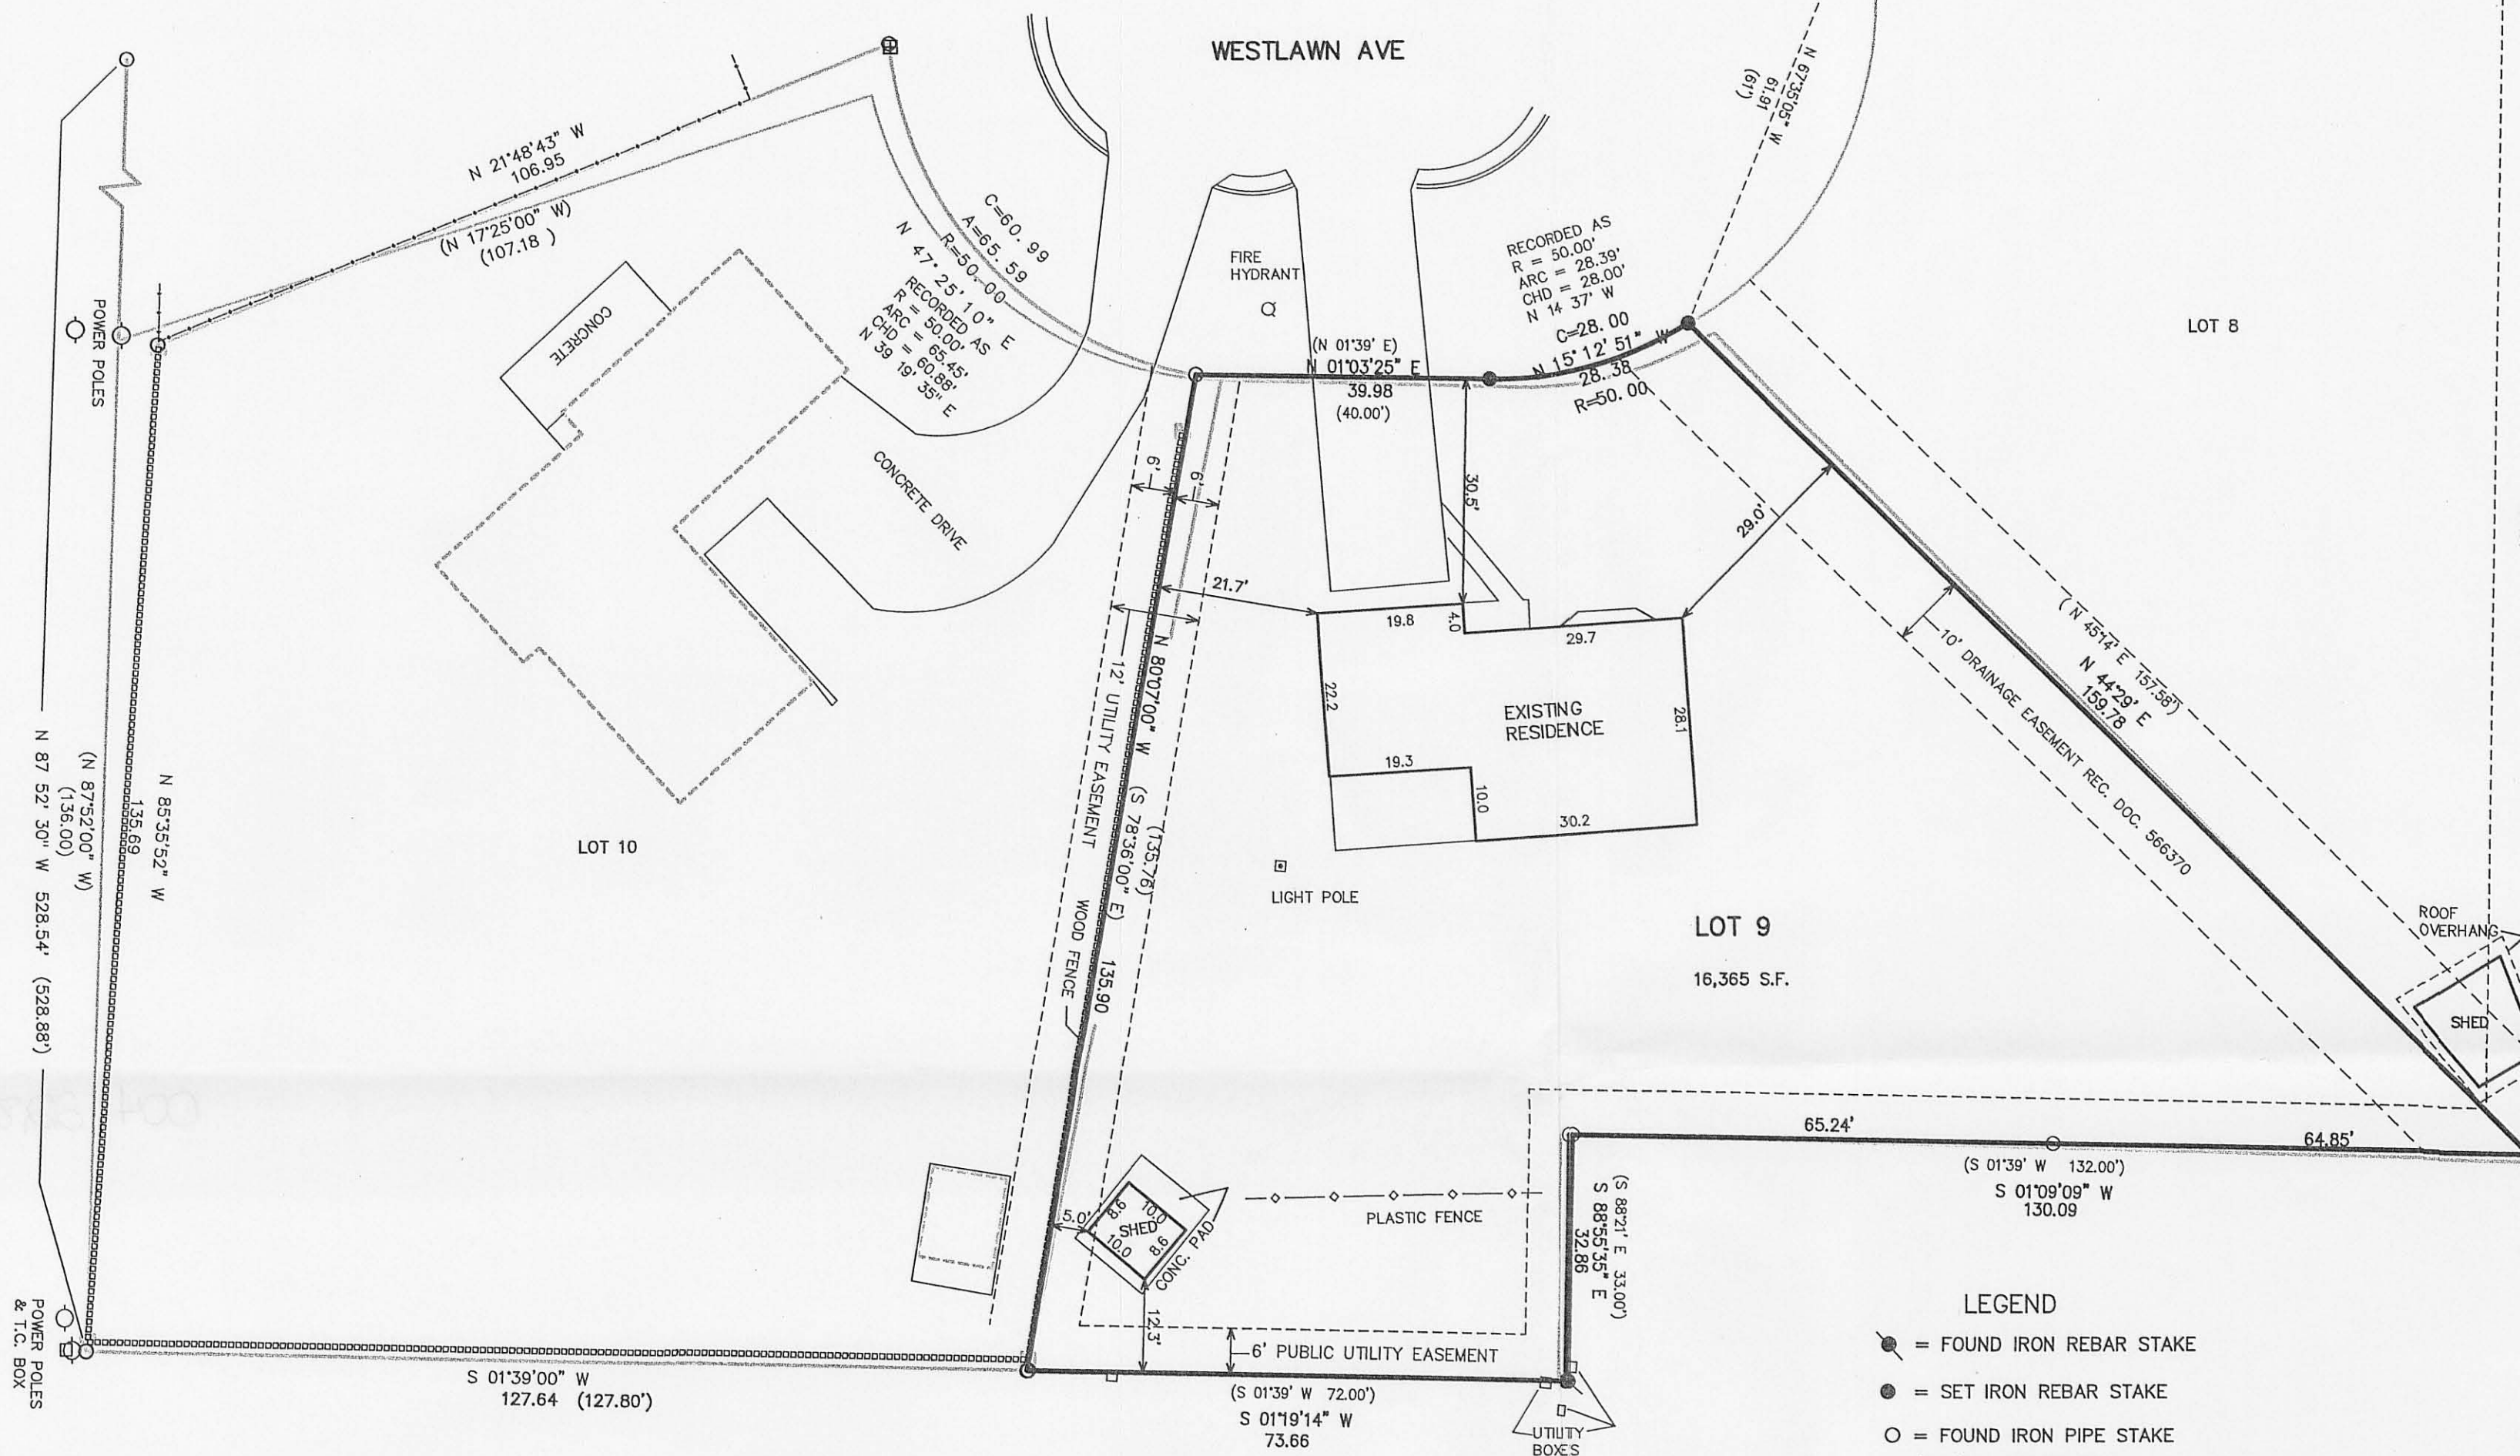




PLAT OF SURVEY
LOT 9 OF BLOCK 1 EDGEWOOD SUBDIVISION FIRST ADD.
LOCATED IN PART OF THE WEST 1/2 OF THE NE 1/4
OF SECTION 36, TOWN 3 NORTH, RANGE 16 EAST,
CITY OF ELKHORN, WALWORTH COUNTY, WISCONSIN

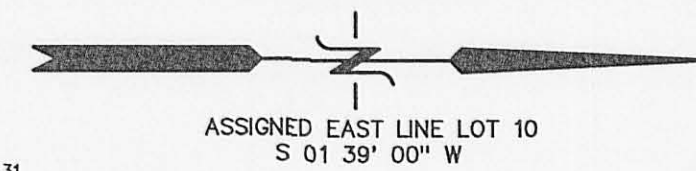

- LEGEND
- = FOUND IRON REBAR STAKE
 - = SET IRON REBAR STAKE
 - = FOUND IRON PIPE STAKE
 - (XXX) = RECORDED AS

SURVEYOR'S NOTE:

THERE IS AN APPARENT DIFFERENCE FROM THE RECORD BOUNDARY FOR THESE LOTS AND THE LINES OF THE LOTS AS MONUMENTED AND OCCUPIED. THE DIFFERENCE IS SHOWN ON THIS MAP. RECORD LOCATION OF THE BOUNDARY IS BASED ON HOLDING THE TWO PIPES ON THE EAST LINE OF LOT 10 AS ORIGINAL CORNERS AND A PIPE FOUND ON THE SOUTH LINE WHICH ROUGHLY MATCHES THE RECORD ANGLE AND DISTANCE FOR THE ORIGINAL BOUNDARY. TO MORE ACCURATELY LOCATE THE ORIGINAL BOUNDARY LINES (LINES OF TITLE) A FULL RESURVEY OF THE SUBDIVISION ALONG WITH ALL LOTS WOULD BE NECESSARY. LEGAL OPINION MAY BE NEEDED AS TO THE POSSIBILITY OF ADVERSE POSSESSION BEING USED TO CLAIM TITLE TO THE LANDS OF OCCUPATION AS OPPOSED TO THE RECORD BOUNDARY LINES AS SHOWN.

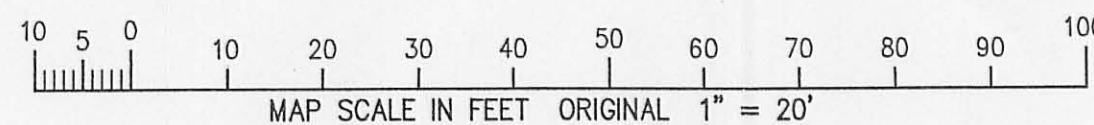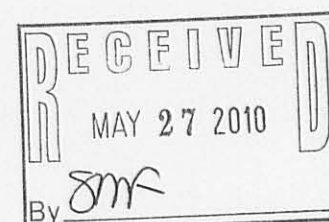


NOTE: COPIES OF THIS MAP TO WHICH THE FOLLOWING CERTIFICATE WILL APPLY SHOW SURVEYOR'S ORIGINAL SEAL AND SIGNATURE IN RED INK. COPIES BY ANY OTHER MEANS MAY HAVE ALTERATIONS WHICH DO NOT REPRESENT THE SURVEYOR'S WORK PRODUCT.

I HEREBY CERTIFY THAT THE ABOVE DESCRIBED PROPERTY HAS BEEN SURVEYED UNDER MY DIRECTION AND THAT THE ABOVE MAP IS A TRUE REPRESENTATION THEREOF AND SHOWS THE SIZE AND LOCATION OF THE PROPERTY, ITS EXTERIOR BOUNDARIES, THE LOCATION OF ALL VISIBLE STRUCTURES, AND DIMENSIONS OF ALL PRINCIPLE BUILDINGS THEREON, BOUNDARY FENCES, APPARENT EASEMENTS, ROADWAYS, AND VISIBLE ENCROACHMENTS, IF ANY. THIS SURVEY IS MADE FOR THE USE OF THE PRESENT OWNERS OF THE PROPERTY, AND ALSO THOSE WHO PURCHASE, MORTGAGE, OR GUARANTEE THE TITLE THERETO WITHIN ONE YEAR FROM THE DATE HEREOF.

DATED: MAY 10, 2010

Peter S. Gordon
PETER S. GORDON R.L.S. 2101

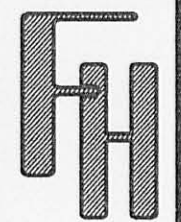

WORK ORDERED BY:
THE RAULAND AGENCY
118 KENOSHA STREET
WALWORTH, WI. 53184

FARRIS, HANSEN & ASSOCIATES, INC.
ENGINEERING - ARCHITECTURE - SURVEYING
7 RIDGWAY COURT P.O. BOX 437
ELKHORN, WISCONSIN 53121
OFFICE: (262) 723-2098 FAX: (262) 723-5886

REVISIONS

PROJECT NO.
8134
DATE:
05-07-2010
SHEET NO.
1 OF 1