


Plat of Survey

of


Lot 9 of Ted's Addition to the City of Elkhorn,

a subdivision located in the Southeast 1/4 of Section 36, Town 3 North,
Range 16 East, City of Elkhorn, Walworth County, Wisconsin.

Surveyed for: **Jeanette Jacobs**
205 Van Buren Street
Elkhorn, Wisconsin. 53121

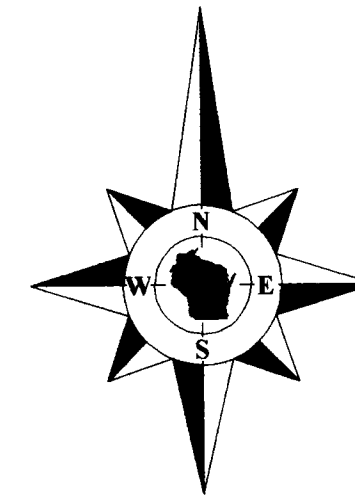


Bearings referenced to the East line of
Van Buren Street recorded as North on
the plat of Ted's Addition to the City
of Elkhorn.

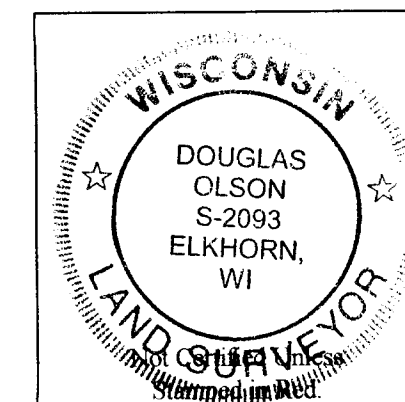

Notes:

- 1) This survey plat is not certified unless signed and sealed in red ink.
- 2) This survey is subject to Wisconsin lien laws. This Plat of Survey is the notice of intent to file lien. Lien waiver required.

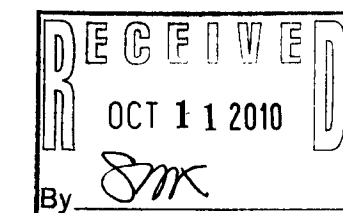


Copyright 2010 by Jensen & Olson Land Surveying, LLC.

All rights reserved. No part of this survey plat may be reproduced or transmitted in any form by any means - graphic, electronic, or mechanical, including photocopying, tracing, or information storage and retrieval systems - without permission in writing from Douglas G. Olson, Jensen & Olson Land Surveying, LLC.

I, Douglas G. Olson, Wisconsin Registered Land Surveyor, do hereby certify that this survey was performed by me, or under my direction in full compliance with the owner's/agent's instructions and Chapter A-E 7 of the Wisconsin Administrative Code "Minimum Standards for Property Surveys"; and that this map is an accurate representation thereof to the best of my knowledge and belief.

Douglas G. Olson
Wisconsin Registered Land Surveyor - 2093

Survey Date: Sept. 13, 2010.
Revisions:

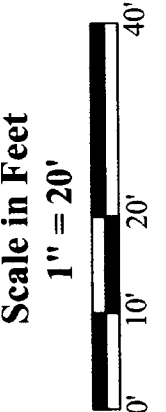


Jensen & Olson Land Surveying, LLC

45 South Wisconsin Street * P.O. Box 322 * Elkhorn, Wisconsin. 53121
Telephone: (262) 723-3434 * Facsimile: (262) 723-8044
Email: jensen.olson@elknet.net

Legend
Found Iron Pipe
Recorded Information
Utility Pole
Asphalt Surface
Concrete Surface
Patio Blocks

Sheet 1 of 1 Sheets
Drawing Name: D:\16-2010088-2010088\Plat.sj
Job Reference Number
2010.088

2010.088

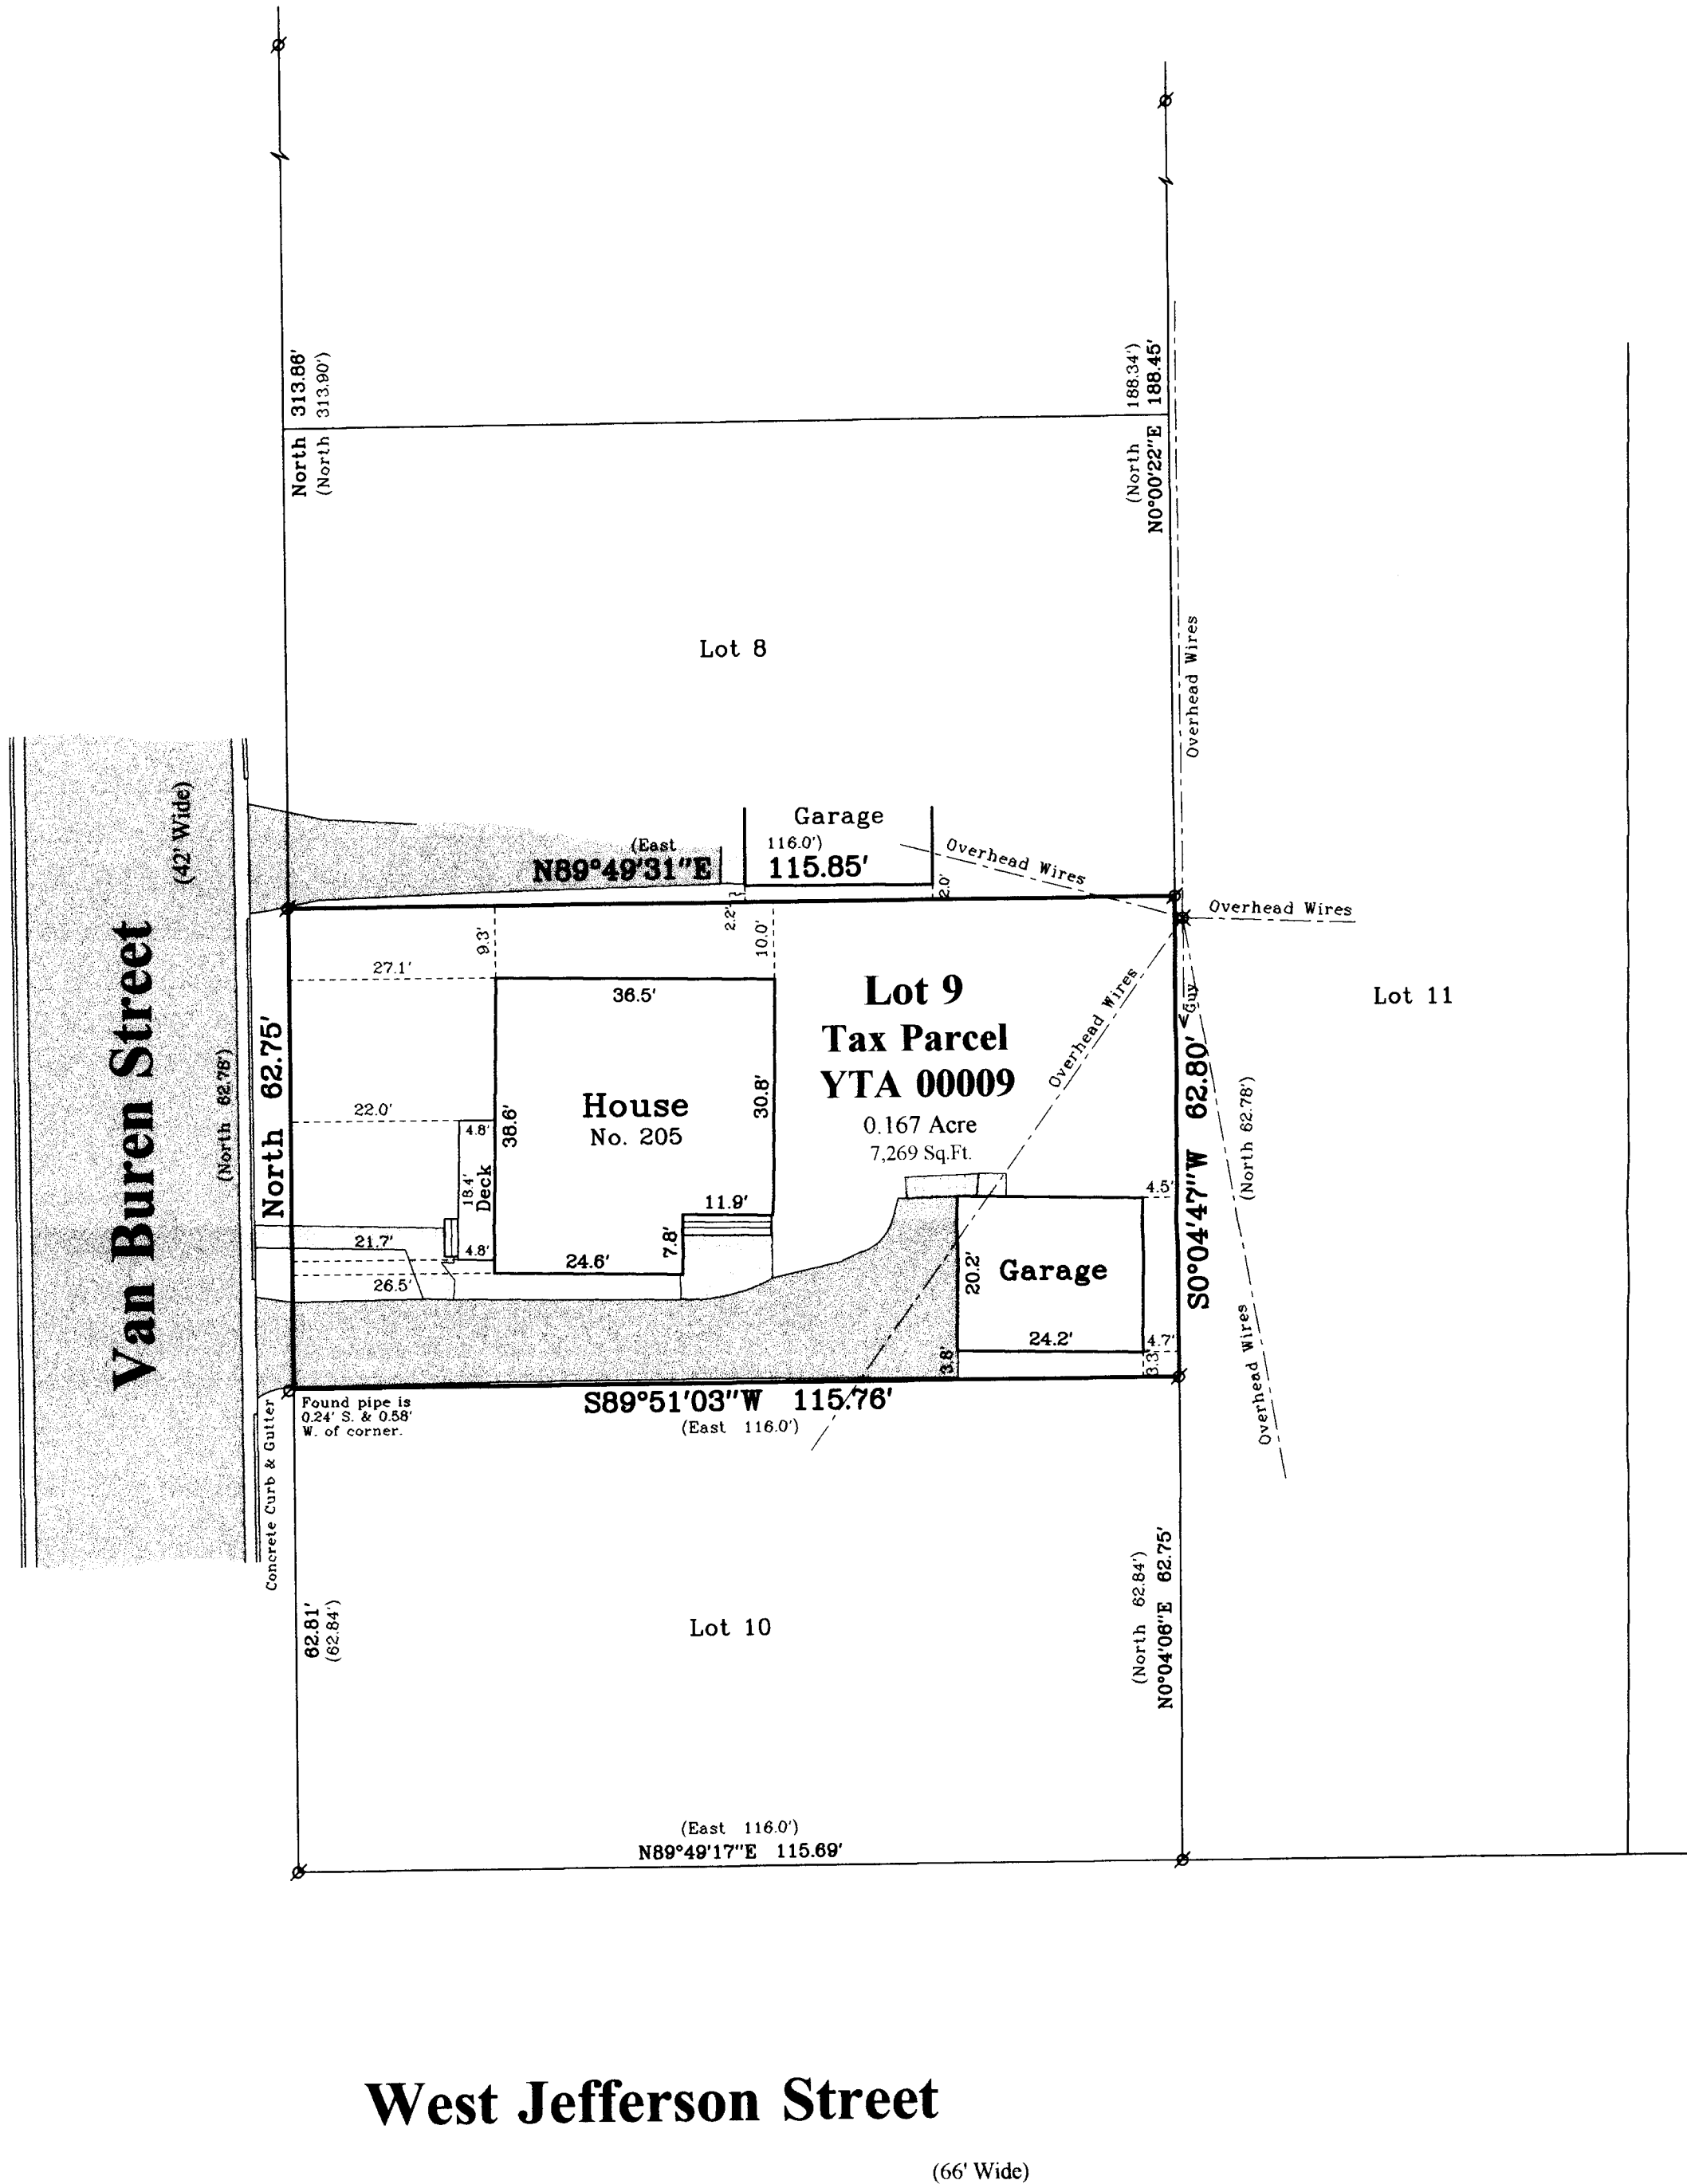

YTA-9

004-2299