


Mark L. Miritz

**N9330 Knuteson Drive
Whitewater, WI 53190
Phone:(262)495-3284
FAX : (262) 495-8421
LAND-MARKSURVEYING.COM**

Lot 6 of The Pines, located in the Northwest, Northeast, Southwest, and Southeast One-quarters (1/4's) of the Southwest One-quarter (1/4) and the Southwest and Northwest One-quarters (1/4's) of the Southeast One-quarter (1/4) of Section Five (5), in Township Two (2) North, Range Seventeen (17) East, in the City of Elkhorn, County of Walworth, State of Wisconsin.

**ORDERED BY:
SHARI RAULAND MOHR
THE RAULAND AGENCY
118 KENOSHA STREET
WALWORTH, WI 53184**

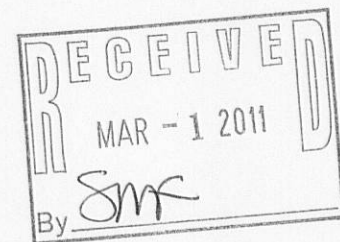

THE REAR YARDS OF LOTS 5,6 & 7 ARE FENCED IN WITH WOOD FENCE OF THE SAME MATERIALS. IT IS NOT READILY APPARENT WHICH FENCE BELONGS TO WHOM.

LOT 5

LOT 6

8,756 SQ. FT.

LOT 7

LEGEND

FOUND IRON PIPE 1 1/4"

EXISTING WOOD FENCE

SCALE: 1 INCH = 20 FEET

"I hereby certify that the above described property has been surveyed by me or under my direction and that the above map is a true representation thereof and shows the size and location of the property, its exterior boundaries, the location of all visible structures and dimensions of all principal buildings thereon, boundary fences, apparent easements, roadways and visible encroachments, if any."

"This survey is made for the use of the present owners of the property, and also those who purchase, mortgage, or guarantee the title thereto within one year from date hereof."

MARK L. MIRITZ
WISCONSIN REGISTERED
LAND SURVEYOR S-2582

DATE: FEB. 26, 2011 JOB NO. 11.207

YPI-6

004-2310